

evoQUA
WATER TECHNOLOGIES

ELECTRIC HYDROGEN
BEAUMONT, TX
PROJECT NUMBER: 2034/001845

	Project No.: 22MH194		
	P.O. No.:	8027	Tag No.:
	1	Approved Without Comments	
	2	Approved With Comments; Revise and Resubmit	
	3	Revise and Resubmit	
	4	For Information Only	
	5	Certified as Final Data	

<u>Ron Perego</u>		<u>9/4/24</u>
Project Manager		Date
<u>Bart Raytar</u>		<u>9/3/24</u>
Project Engineer		Date
<u>Mark Burton</u>		<u>8/21/24</u>
EH2 Representative		Date

SHEET	PART NUMBER	FILENAME/DRAWING	DRAWING DESCRIPTION
1	W3T625446	V112057485-01	COVER SHEET
2	W3T625446	V112057485-02	ELECTRICAL SCHEMATIC NOTES
3	W3T625446	V112057485-03	POWER DISTRIBUTION - 120VAC & 24VDC
4	W3T625446	V112057485-04	INTERCONNECT
5	W3T625446	V112057485-05	ELECTRICAL ENCLOSURE NOTES & EXTERIOR DETAIL
6	W3T625446	V112057485-06	ELECTRICAL ENCLOSURE CUTOUT
7	W3T625446	V112057485-07	ELECTRICAL ENCLOSURE SUB PANEL LAYOUT
8	W3T625446	V112057485-08	ELECTRICAL TERMINAL LAYOUT
9	W3T625446	V112057485-09	ELECTRICAL NAME PLATE SCHEDULE

COMPANY CONFIDENTIAL INFORMATION THIS DOCUMENT AND ALL INFORMATION CONTAINED HEREIN, INCLUDING THE DESIGN CONCEPTS AND THOSE ARISING THEREFROM, ARE THE PROPERTY OF EVOQUA AND/OR ITS AFFILIATES AND ARE SUBMITTED IN CONFIDENCE. THEY MAY BE USED ONLY FOR THE EXPRESS PURPOSE FOR WHICH THEY ARE PROVIDED AND MUST NOT BE DISCLOSED, REPRODUCED, OR COPIED IN ANY FORM, INCLUDING IN ELECTRONIC FORMAT, LOANED OR USED IN ANY OTHER MANNER WITHOUT THE EXPRESS WRITTEN CONSENT OF EVOQUA. ALL PATENT RIGHTS ARE RESERVED. THIS DOCUMENT AND DERIVATIVE WORKS THEREOF ARE PROTECTED UNDER APPLICABLE COPYRIGHT LAWS. UPON DEMAND OF EVOQUA, THIS DOCUMENT, ALONG WITH ALL COPIES AND EXTRACTS, AND ALL RELATED NOTES AND ANALYSES MUST BE RETURNED TO EVOQUA OR DESTROYED, AS INSTRUCTED BY EVOQUA. ACCEPTANCE OF THE DELIVERY OF THIS DOCUMENT CONSTITUTES AGREEMENT TO THESE TERMS.							DWN BY:	DATE:	TITLE:	ELECTRICAL SCHEMATICS & ENCLOSURE DIAGRAMS (CETLUS) CONTAINER INTERFACE JUNCTION BOX JB-0117					
							C.HANER	2024-08-06	CLIENT:						
							CKD BY:	DATE:	K.KALUNG	2024-08-06	CLIENT:	ELECTRIC HYDROGEN BEAUMONT, TX			
							APPD BY:	DATE:	K.KALUNG	2024-08-06					
							MGD BY:	SCALE:	P.RYAN	NTS	EVOQUA WATER TECHNOLOGIES COLORADO SPRINGS CO USA +1 719-570-9600				
							PART NUMBER:	PROJ/PROD NUMBER:	CODE:	FILE/DRAWING NUMBER:					SHEET:
0	ISSUED FOR MANUFACTURING	2024-08-07	C.HANER	K.KALUNG	K.KALUNG	N/A	W3T625446	2034/001845	EC-DOS03	V112057485-01	1	OF 9	0		
REV	DESCRIPTION	DATE	DWN	CKD	APPD	ECN									

ELECTRICAL SCHEMATIC NOTES

NOTES: UNLESS OTHERWISE SPECIFIED


1. ALL INTERNAL PANEL WIRING TO BE #14 AWG EXCEPT CLASS 2 CONTROL CIRCUITS AND PLC I/O TO BE #18 AWG.
2.  DENOTES REMOTE PANELS OR COMPONENT(S).
3. ALL FIELD WIRING TO BE COPPER CONDUCTORS SIZED AT MIN 60°C.
4. - - - - - DENOTES SKID WIRING BY FACTORY.
5. - - - - - DENOTES FIELD WIRING TO EXTERNAL COMPONENTS (BY OTHERS).
6. WIRE COLORS:


BLK	120/230V AND ABOVE POWER
RED	120/230V CONTROL
WHT	NEUTRAL
BLU	DC POSITIVE
BLU/WHT	DC UNGROUNDED COMMON
WHT/BLU	DC GROUNDED COMMON
ORG	EXTERNALLY POWERED OR UNGROUNDED CONDUCTORS REMAINING ENERGIZED WHEN MAIN SUPPLY CIRCUIT DISCONNECT IS IN OFF POSITION
WHT/ORG	DISCONNECT AC CIRCUIT CONDUCTOR REMAINING ENERGIZED WHEN MAIN SUPPLY CIRCUIT DISCONNECT IS IN OFF POSITION
GRN/YEL	GROUNDING
7. ALL SKID WIRING TO BE #14 AWG THHN MINIMUM, EXCEPT FOR MULTI-CONDUCTOR CABLES WITH OVERALL JACKET.
8. SHIELDED SIGNAL CABLE FOR CLASS 1 CONTROL CIRCUITS TO BE 600V BELDEN 1120A OR EQUIVALENT.
9. SHIELDED SIGNAL CABLE FOR CLASS 2 CONTROL CIRCUITS TO BE 300V BELDEN 8760 OR EQUIVALENT.
10. - - c - - c - - DENOTES CONTAINER WIRING BY FACTORY.

	Project No.: 22MH194		
	P.O. No.:	8027	Tag No.:
1	Approved Without Comments		
2	Approved With Comments; Revise and Resubmit		
3	Revise and Resubmit		
4	For Information Only		
5	Certified as Final Data		

Ron Perego	9/4/24
Project Manager	Date
Bart Raytar	9/3/24
Project Engineer	Date
Mark Burton	8/21/24
EH2 Representative	Date


[illegible]

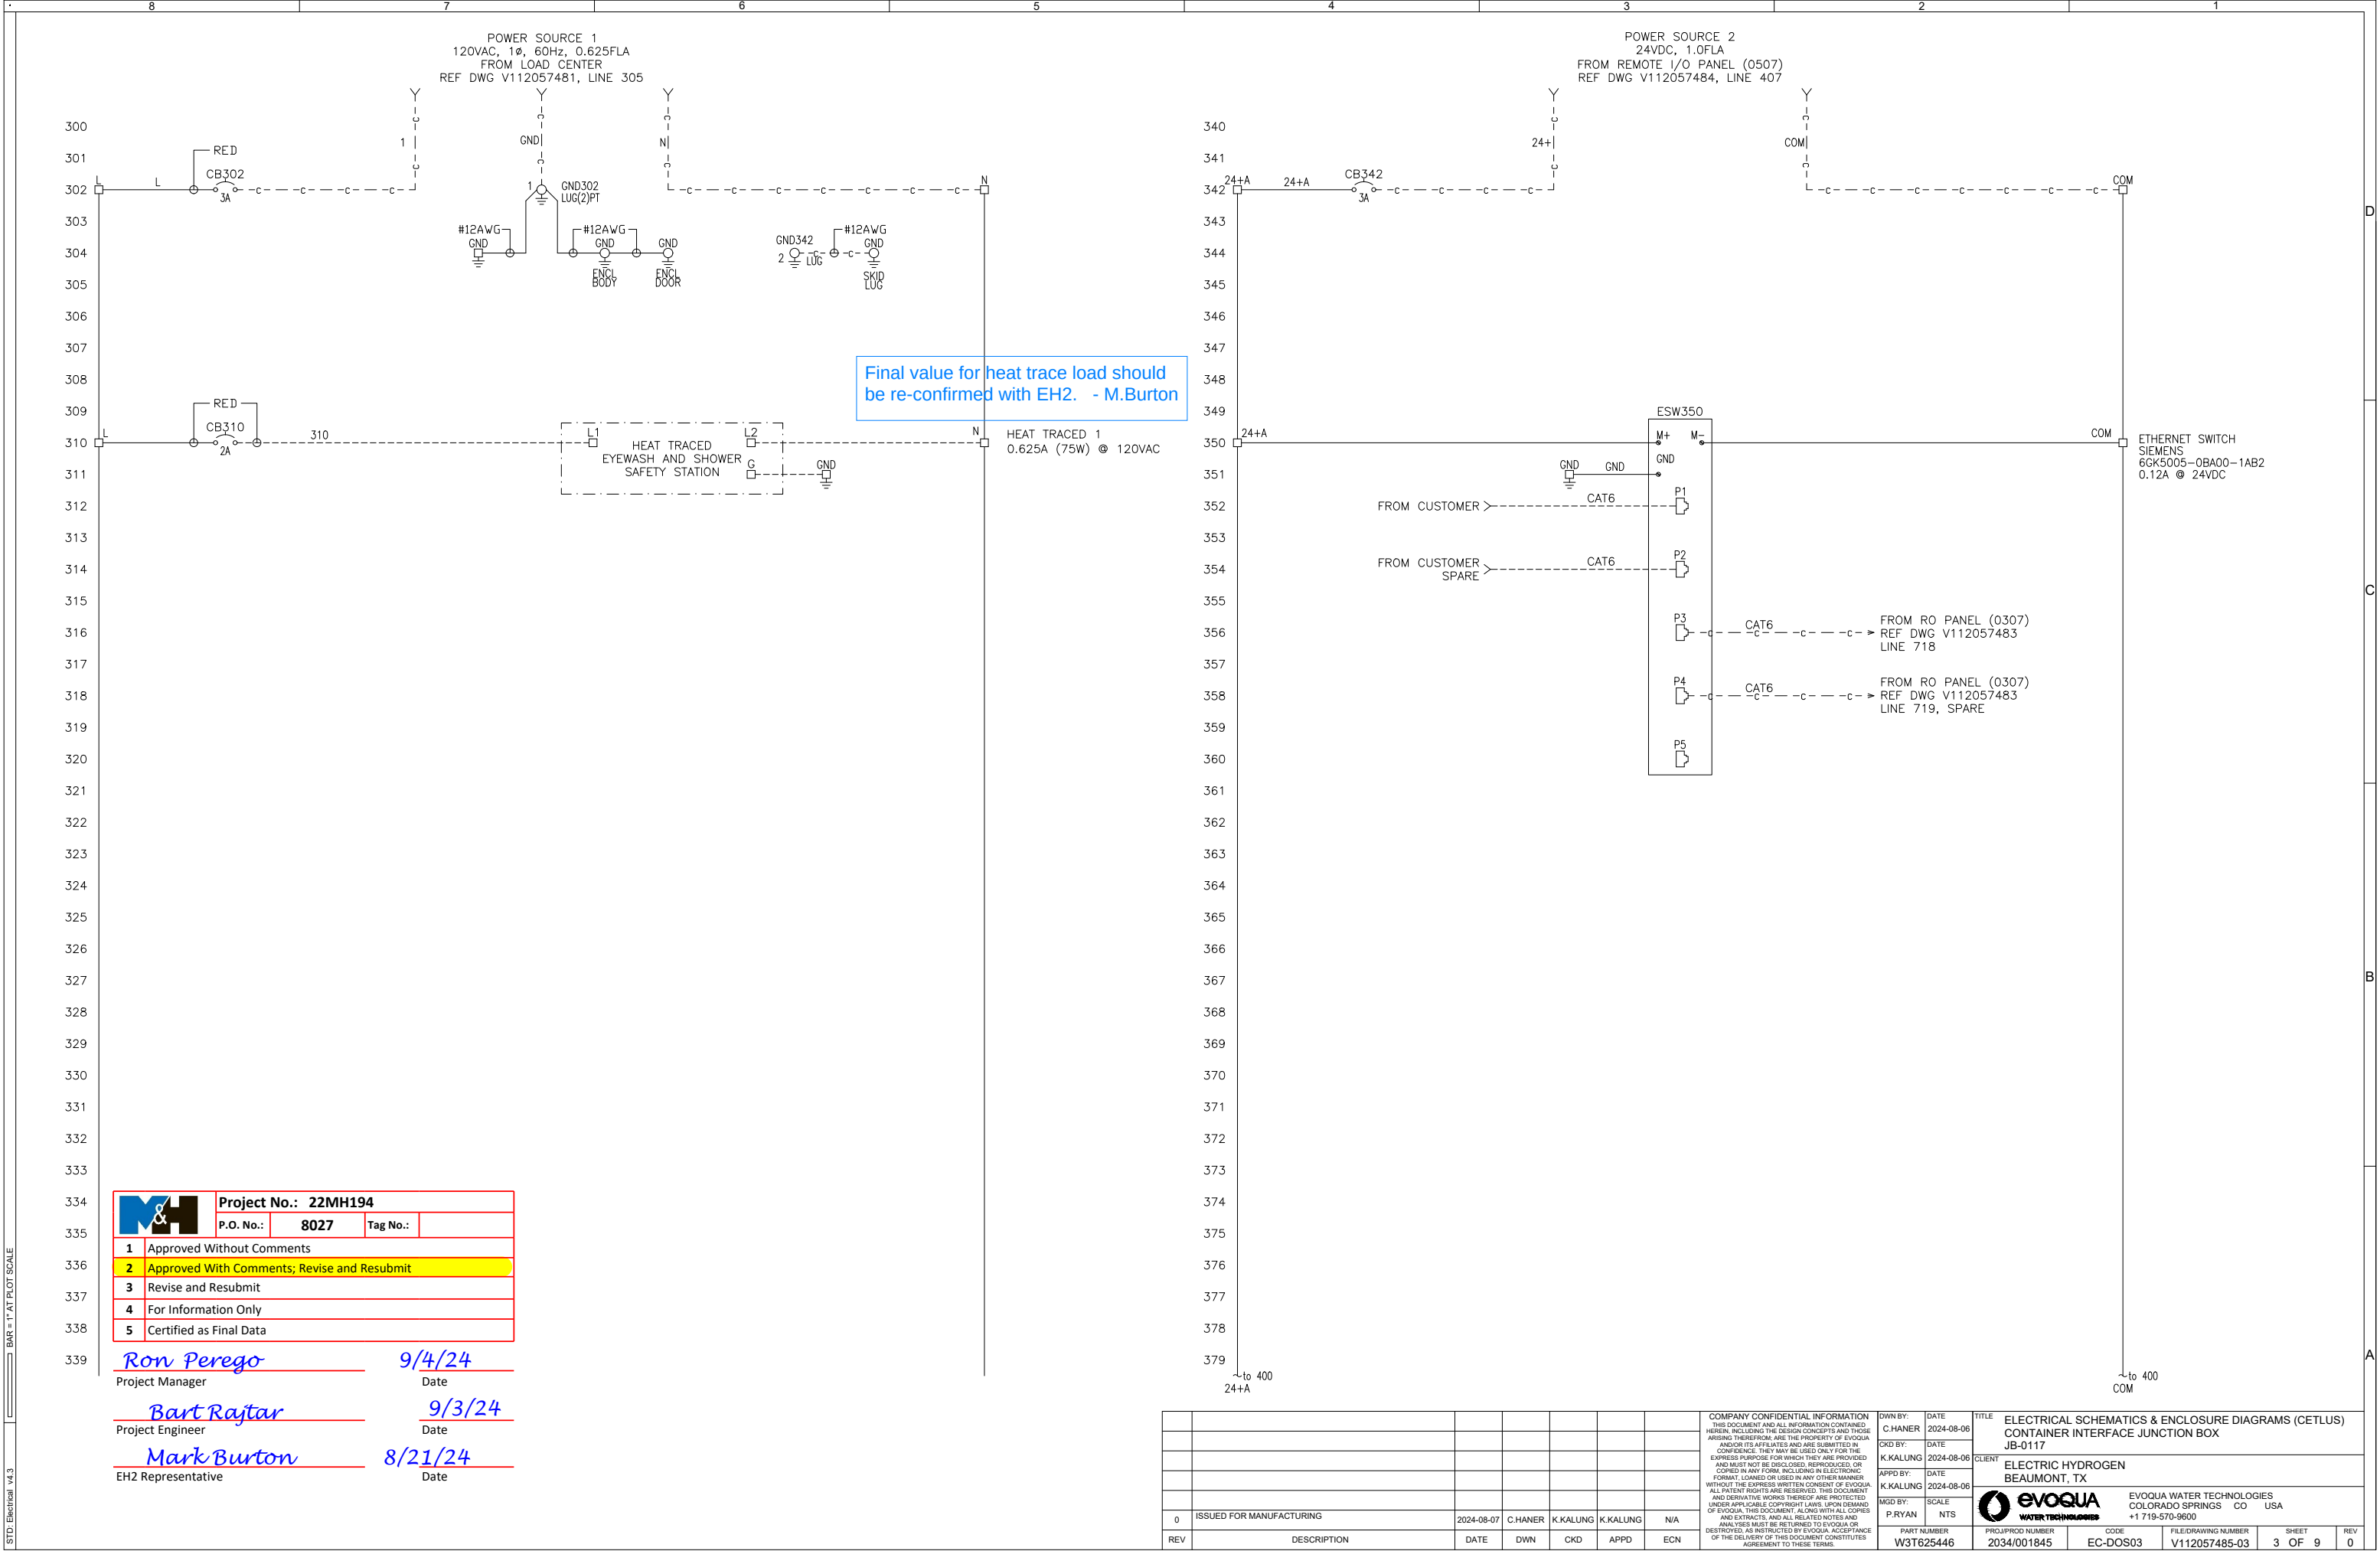

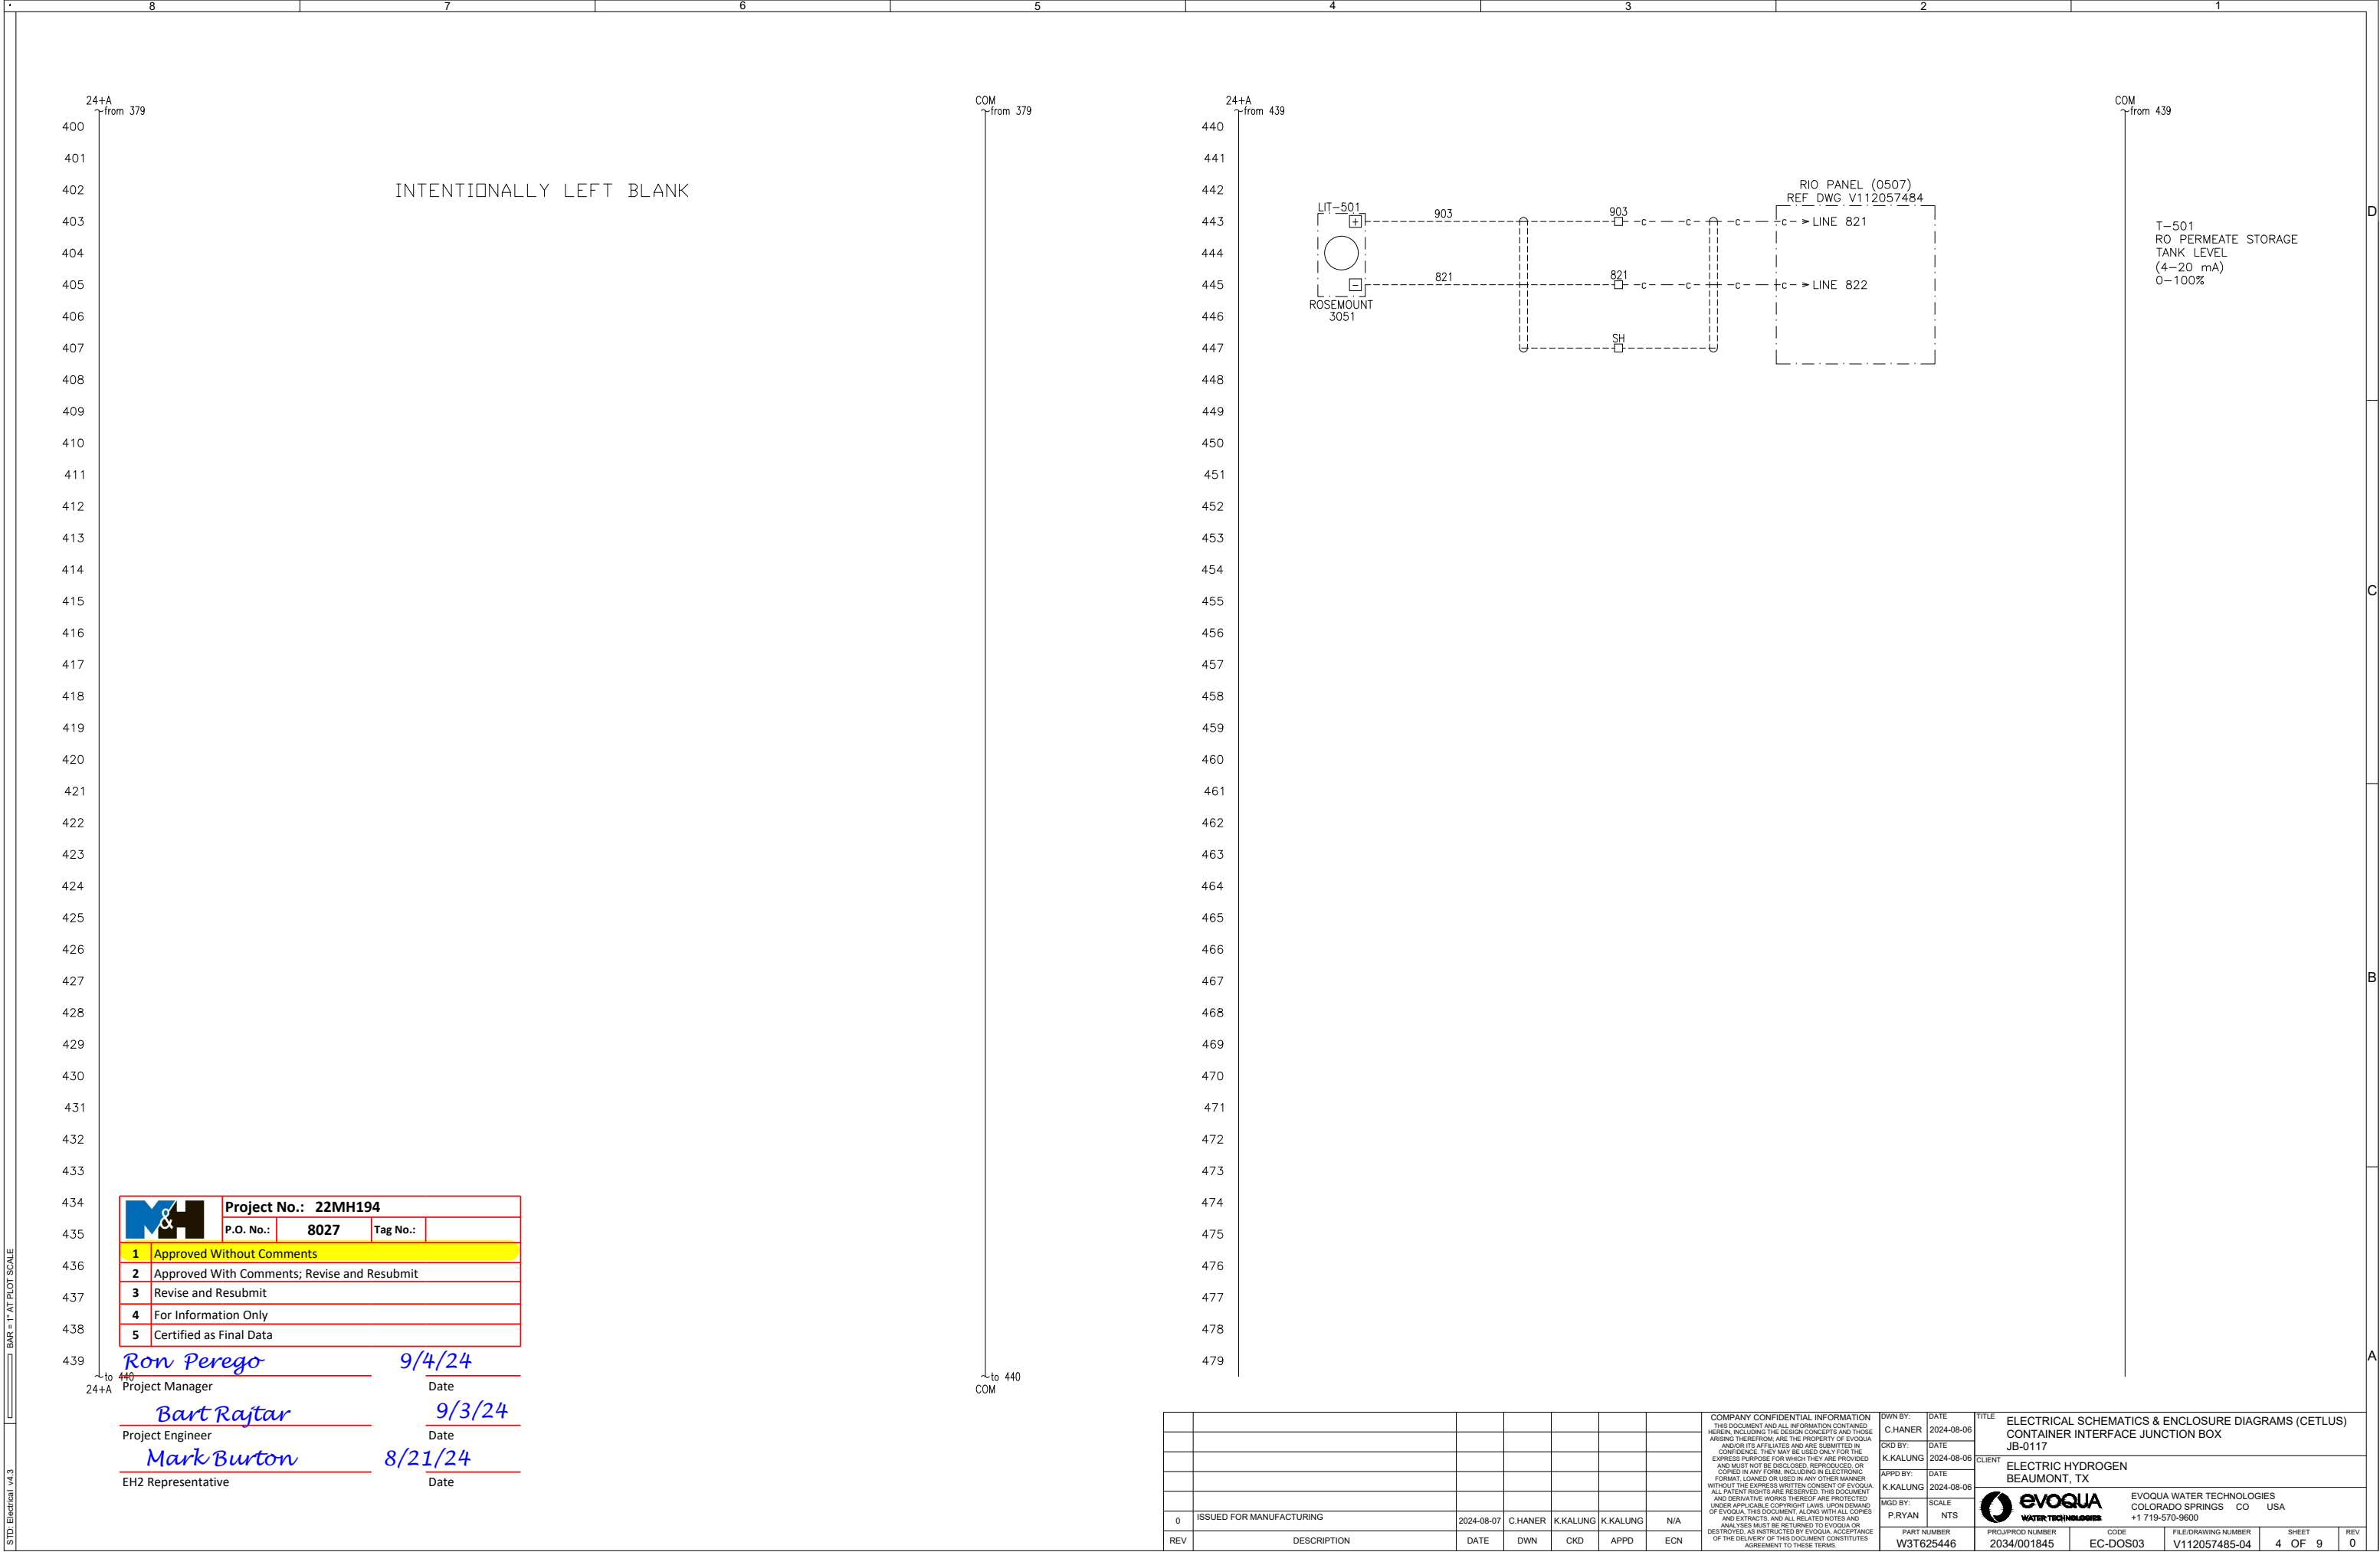


NOTES: UNLESS OTHERWISE SPECIFIED

1. THIS PANEL TO BE MOUNTED ON FRONT EXTERIOR OF CONTAINER.
2. THIS ENCLOSURE IS TO BE NEMA 4X STAINLESS STEEL.
3. MANUFACTURING TO LAYOUT BACKPANEL AS SHOWN.
4. MANUFACTURING TO VERIFY ALL DIMENSIONS AND CUTOUT SIZES BEFORE CUTTING OR DRILLING PANEL.
5. WIREWAY TO BE 4" DEEP.
6. DIN RAIL TO BE MOUNTED ON 1" STANDOFFS.
8. DRAIN / VENT TO BE LOCATED AND INSTALLED BY SKID ELECTRIC.

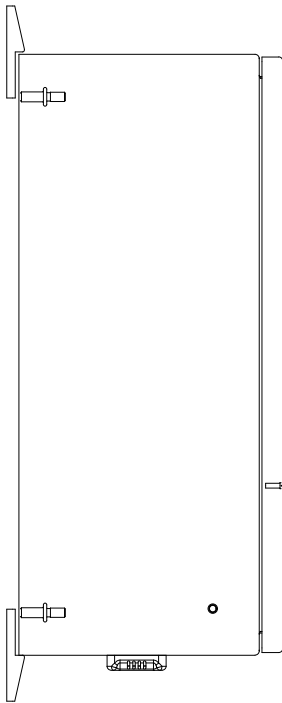

LEFT SIDE DETAIL


ENCLOSURE
MOUNTING FOOT KIT

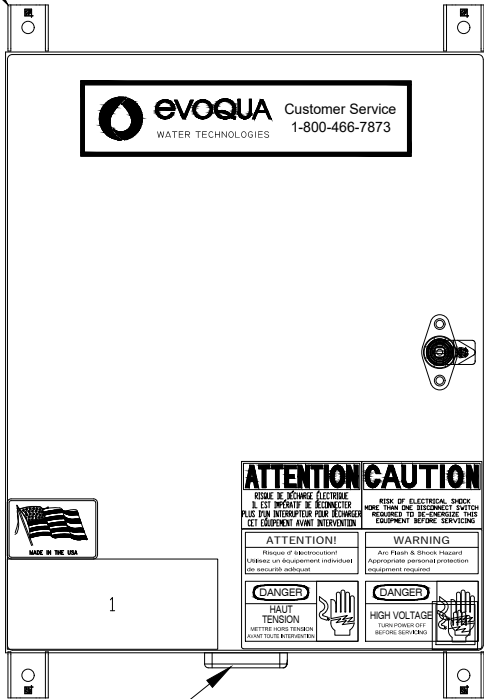

SEE NOTE 8

PANEL DETAIL

20"x16"x8"
[508mm x 406mm x 203mm]

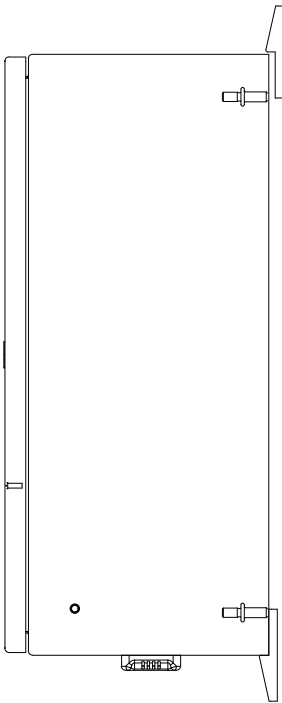


RIGHT SIDE DETAIL

	Project No.: 22MH194		
	P.O. No.:	8027	Tag No.:
1	Approved Without Comments		
2	Approved With Comments; Revise and Resubmit		
3	Revise and Resubmit		
4	For Information Only		
5	Certified as Final Data		


<u>Ron Perego</u>	<u>9/4/24</u>
Project Manager	Date
<u>Bart Rajtar</u>	<u>9/3/24</u>
Project Engineer	Date
<u>Mark Burton</u>	<u>8/21/24</u>
EH2 Representative	Date

							COMPANY CONFIDENTIAL INFORMATION THIS DOCUMENT AND ALL INFORMATION CONTAINED HEREIN, INCLUDING THE DESIGN CONCEPTS AND THOSE ARISING THEREFROM, ARE THE PROPERTY OF EVOQUA AND/OR ITS AFFILIATES AND ARE SUBMITTED IN CONFERENCE. THEY MAY BE USED ONLY FOR THE EXPRESS PURPOSE FOR WHICH THEY ARE PROVIDED AND MUST NOT BE DISCLOSED, REPRODUCED, OR COPIED IN ANY FORM, INCLUDING IN ELECTRONIC FORMAT, LOANED OR USED IN ANY OTHER MANNER WITHOUT THE EXPRESS WRITTEN CONSENT OF EVOQUA. ALL PATENT RIGHTS ARE RESERVED. THIS DOCUMENT AND DERIVATIVE WORKS THEREOF ARE PROTECTED UNDER APPLICABLE COPYRIGHT LAWS. UPON DEMAND OF EVOQUA, THIS DOCUMENT, ALONG WITH ALL COPIES AND EXTRACTS, AND ALL RELATED NOTES AND ANALYSES MUST BE RETURNED TO EVOQUA OR DESTROYED, AS INSTRUCTED BY EVOQUA. ACCEPTANCE OF THE DELIVERY OF THIS DOCUMENT CONSTITUTES AGREEMENT TO THESE TERMS.		DWN BY: C.HANER	DATE: 2024-08-06	TITLE: ELECTRICAL SCHEMATICS & ENCLOSURE DIAGRAMS (CETLUS) CONTAINER INTERFACE JUNCTION BOX JB-0117	
							CKD BY: K.KALUNG	DATE: 2024-08-06	CLIENT: ELECTRIC HYDROGEN BEAUMONT, TX			
							APPD BY: K.KALUNG	DATE: 2024-08-06				
							MGD BY: P.RYAN	SCALE: NTS	 EVOQUA WATER TECHNOLOGIES COLORADO SPRINGS CO USA +1 719-570-9600			
0	ISSUED FOR MANUFACTURING	2024-08-07	C.HANER	K.KALUNG	K.KALUNG	N/A	PART NUMBER: W3T625446	PROJ/PROD NUMBER: 2034/001845	CODE: EC-DOS03	FILE/DRAWING NUMBER: V112057485-05	SHEET: 5 OF 9	REV: 0
REV	DESCRIPTION	DATE	DWN	CKD	APPD	ECN						


NOTES: SEE SHEET ONE

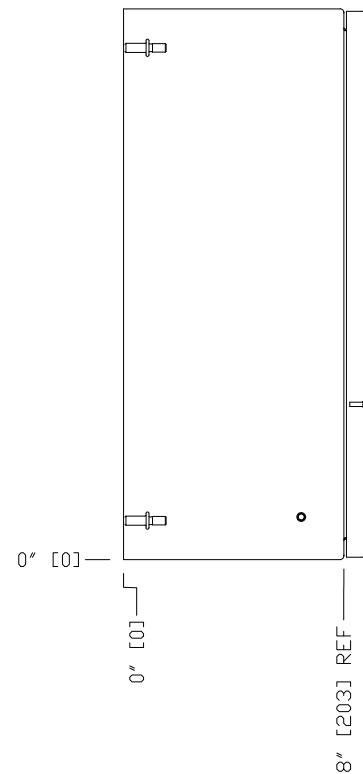


LEFT SIDE DETAIL

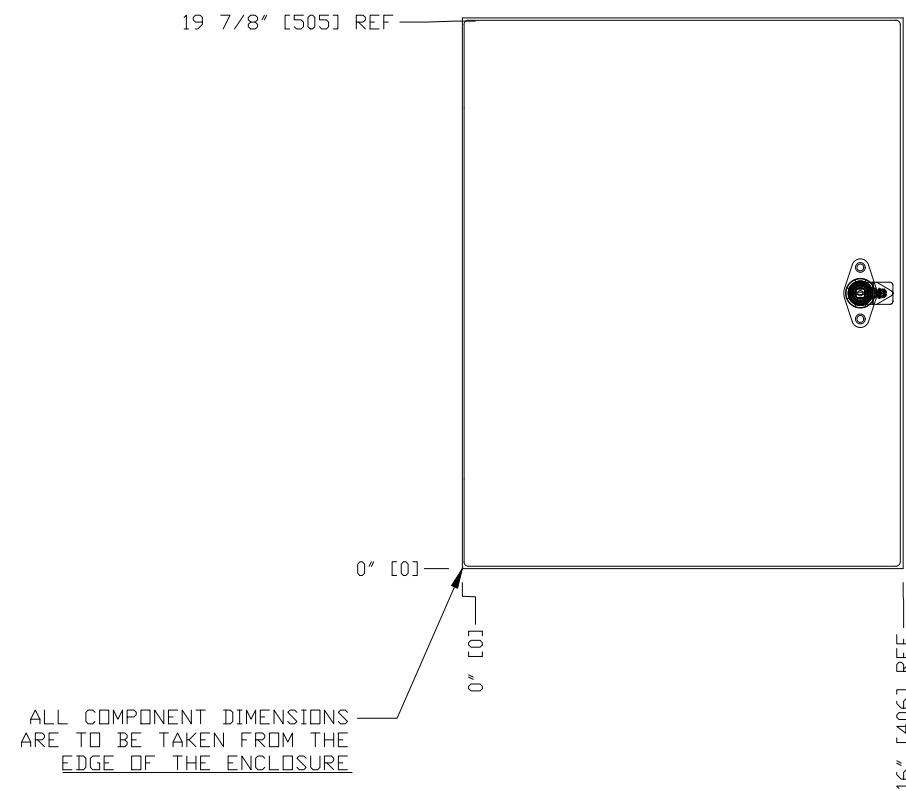


PANEL DETAIL

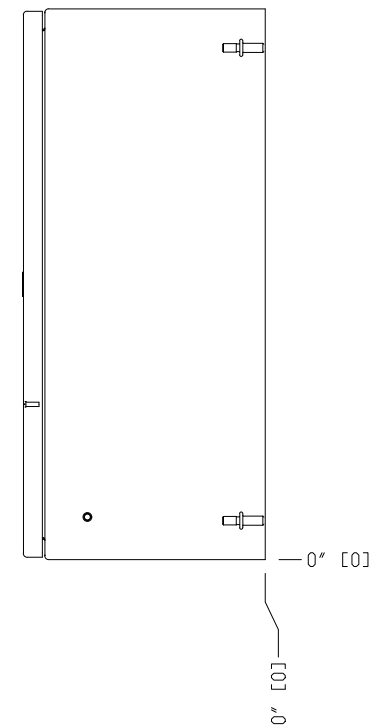

RIGHT SIDE DETAIL

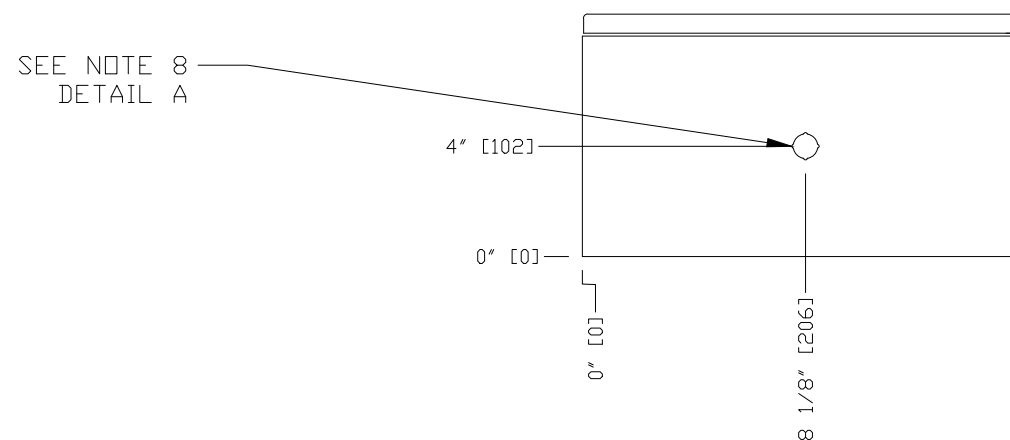

RIGHT SIDE DETAIL

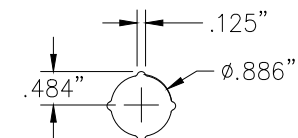


DETAIL A

	Project No.: 22MH194		
	P.O. No.:	8027	Tag No.:
1	Approved Without Comments		
2	Approved With Comments; Revise and Resubmit		
3	Revise and Resubmit		
4	For Information Only		
5	Certified as Final Data		


Ron Perego	9/4/24
Project Manager	Date
Bart Raytar	9/3/24
Project Engineer	Date
Mark Burton	8/21/24
EH2 Representative	Date

[illegible]

NOTES: SEE SHEET ONE

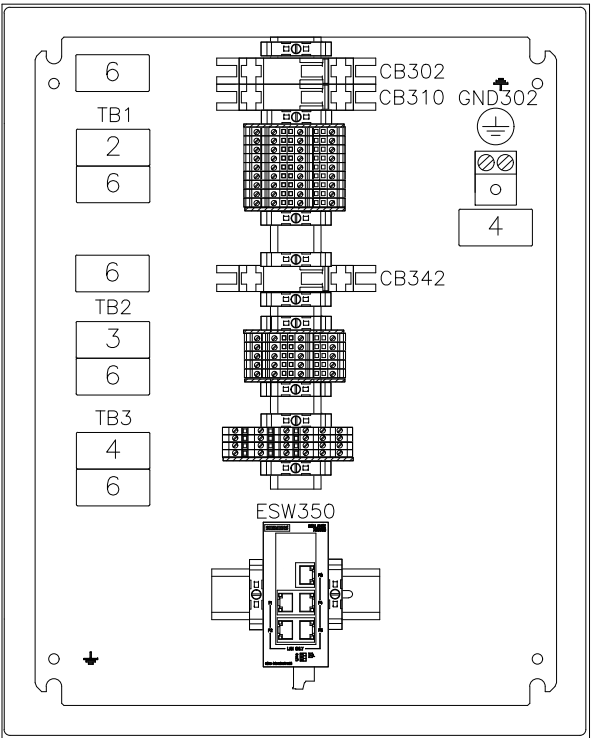

BACKPANEL LAYOUT

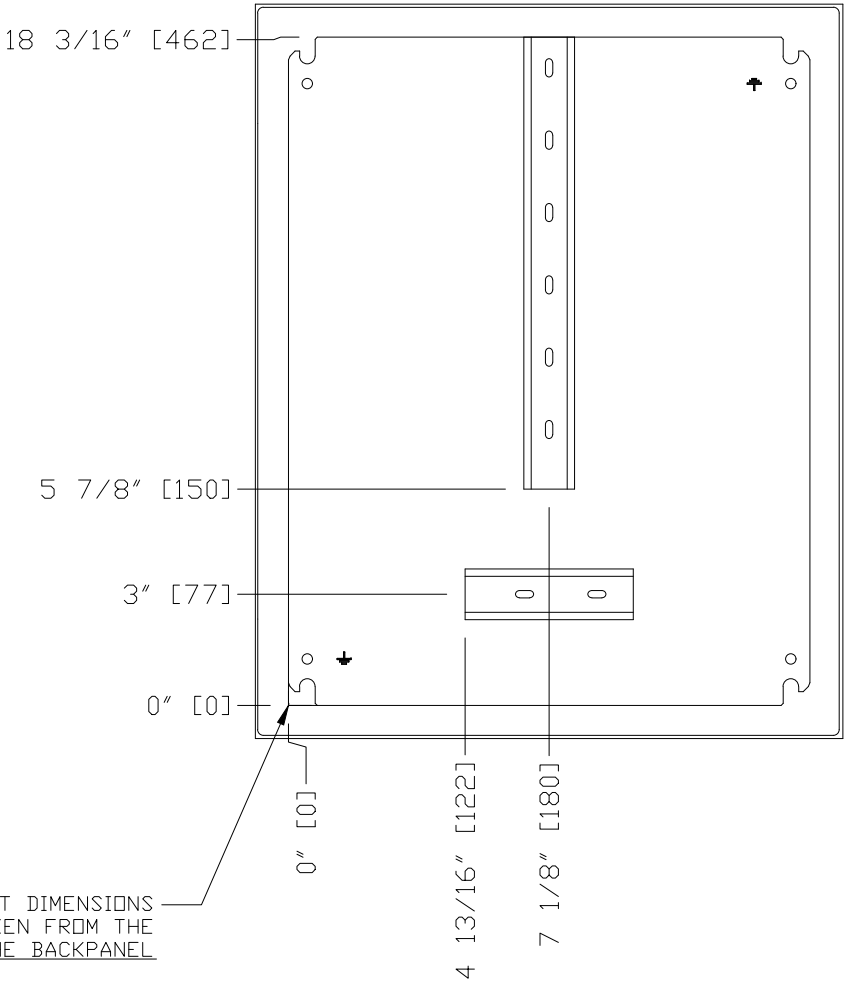

ALL COMPONENT DIMENSIONS
ARE TO BE TAKEN FROM THE
EDGE OF THE BACKPANEL

BACKPANEL DETAIL

	Project No.: 22MH194		
	P.O. No.:	8027	Tag No.:
1	Approved Without Comments		
2	Approved With Comments; Revise and Resubmit		
3	Revise and Resubmit		
4	For Information Only		
5	Certified as Final Data		

Ron Perego		9/4/24
Project Manager		Date
Bart Raytar		9/3/24
Project Engineer		Date
Mark Burton		8/21/24
EH2 Representative		Date

							COMPANY CONFIDENTIAL INFORMATION THIS DOCUMENT AND ALL INFORMATION CONTAINED HEREIN, INCLUDING THE DESIGN CONCEPTS AND THOSE ARISING THEREFROM, ARE THE PROPERTY OF EVOQUA AND/OR ITS AFFILIATES AND ARE SUBMITTED IN CONFERENCE. THEY MAY BE USED ONLY FOR THE EXPRESS PURPOSE FOR WHICH THEY ARE PROVIDED AND MUST NOT BE DISCLOSED, REPRODUCED, OR COPIED IN ANY FORM, INCLUDING IN ELECTRONIC FORMAT, LOANED OR USED IN ANY OTHER MANNER WITHOUT THE EXPRESS WRITTEN CONSENT OF EVOQUA. ALL PATENT RIGHTS ARE RESERVED. THIS DOCUMENT AND DERIVATIVE WORKS THEREOF ARE PROTECTED UNDER APPLICABLE COPYRIGHT LAWS. UPON DEMAND OF EVOQUA, THIS DOCUMENT, ALONG WITH ALL COPIES AND EXTRACTS, AND ALL RELATED NOTES AND ANALYSES MUST BE RETURNED TO EVOQUA OR DESTROYED, AS INSTRUCTED BY EVOQUA. ACCEPTANCE OF THE DELIVERY OF THIS DOCUMENT CONSTITUTES AGREEMENT TO THESE TERMS.		DWN BY:	DATE:	TITLE:				
							C.HANER	2024-08-06	ELECTRICAL SCHEMATICS & ENCLOSURE DIAGRAMS (CETLUS) CONTAINER INTERFACE JUNCTION BOX						
							CKD BY:	DATE:	JB-0117						
							K.KALUNG	2024-08-06	CLIENT:	ELECTRIC HYDROGEN BEAUMONT, TX					
							APPD BY:	DATE:							
							K.KALUNG	2024-08-06							
							MGD BY:	SCALE:							
							P.RYAN	NTS	EVOQUA WATER TECHNOLOGIES COLORADO SPRINGS CO USA +1719-570-9600						
0	ISSUED FOR MANUFACTURING		2024-08-07	C.HANER	K.KALUNG	K.KALUNG	N/A								
REV	DESCRIPTION		DATE	DWN	CKD	APPD	ECN	PART NUMBER	PROJ/PROD NUMBER	CODE	FILE/DRAWING NUMBER	SHEET	REV		
								W3T625446	2034/001845	EC-DOS03	V112057485-07	7 OF 9	0		

		TB1 - DC	
		BOTTOM	TOP
1	N	L	
	N	L	
	N	L	
	SPARE	SPARE	
	SPARE	SPARE	
	GND	GND	
	GND	GND	
9	GND	GND	
	GND	GND	

TB2 - DC		
	BOTTOM	TOP
1	COM	24+A
	COM	24+A
	COM	24+A
	SPARE	SPARE
5	SPARE	SPARE

TB3 - DC			
BOTTOM		MIDDLE	TOP
1	SH	821	903
	SPARE	SPARE	SPARE
	SPARE	SPARE	SPARE
4	SPARE	SPARE	SPARE

	Project No.: 22MH194		
	P.O. No.:	8027	Tag No.:
1	Approved Without Comments		
2	Approved With Comments; Revise and Resubmit		
3	Revise and Resubmit		
4	For Information Only		
5	Certified as Final Data		

Ron Perego	9/4/24
Project Manager	Date
Bart Rajtar	9/3/24
Project Engineer	Date
Mark Burton	8/21/24
EH2 Representative	Date

											COMPANY CONFIDENTIAL INFORMATION THIS DOCUMENT AND ALL INFORMATION CONTAINED HEREIN, INCLUDING THE DESIGN CONCEPTS AND THOSE ARISING THEREFROM, ARE THE PROPERTY OF EVOQUA AND/OR ITS AFFILIATES AND ARE SUBMITTED IN CONFIDENCE. THEY MAY BE USED ONLY FOR THE EXPRESS PURPOSES FOR WHICH THEY ARE PROVIDED AND MUST NOT BE REPRODUCED, COPIED, REPRODUCED, COPIED IN ANY FORM, OR USED IN ANY OTHER MANNER WITHOUT THE EXPRESS WRITTEN CONSENT OF EVOQUA. ALL PATENT RIGHTS ARE RESERVED. THIS DOCUMENT AND DERIVATIVE WORKS THEREOF ARE PROTECTED UNDER APPLICABLE COPYRIGHT LAWS. UPON DEMAND OF EVOQUA, THIS DOCUMENT, ALONG WITH ALL COPIES AND EXTRACTS, AND ALL RELATED MATERIALS AND ANALYSES MUST BE RETURNED TO EVOQUA OR DESTROYED AS INSTRUCTED BY EVOQUA. ACCEPTANCE OF THE DELIVERY OF THIS DOCUMENT CONSTITUTES AGREEMENT TO THESE TERMS.		DWN BY:	DATE	TITLE							
											C.HANER		2024-08-06	ELECTRICAL SCHEMATICS & ENCLOSURE DIAGRAMS (CETLUS) CONTAINER INTERFACE JUNCTION BOX JB-0117								
											CKD BY:		2024-08-06	CLIENT	ELECTRIC HYDROGEN BEAUMONT, TX							
											APPD BY:		DATE	K.KALUNG	2024-08-06							
											MGB BY:		SCALE			EVOQUA WATER TECHNOLOGIES COLUMBO SPRINGS CO USA +1 719-570-9600						
											P.RYAN		NTS									
0	ISSUED FOR MANUFACTURING		2024-08-07	C.HANER	K.KALUNG	K.KALUNG	N/A			PART NUMBER		PROJ/PROD NUMBER		CODE		FILE/DRAWING NUMBER		SHEET		REV		
REV	DESCRIPTION		DATE	DWN	CKD	APPD	ECN			W3T625446		2034/001845		EC-DOS03		V112057485-08		8 OF 9		0		

2X

PANEL NAMEPLATE

PANEL NAMEPLATE



P.O. No.: **8027**

P.O. No.: 8027

1	Approved Without Comments
---	---------------------------

3 Revise and Resubmit

5	Certified as Final Data
---	-------------------------

Project Manager

Date

Project Engineer

Date

Eh2 Representative

Date

COMPANY CONFIDENTIAL INFORMATION
THIS DOCUMENT AND ALL INFORMATION CONTAINED HEREIN, INCLUDING THE DESIGN CONCEPTS AND THOSE ARISING THEREFROM, ARE THE PROPERTY OF EVQVOLA AND/OR ITS AFFILIATES AND ARE SUBMITTED TO YOU ON THE CONDITION THAT YOU WILL NOT DISCLOSE OR EXPRESS PURPOSE FOR WHICH THEY ARE PROVIDED, AND MUST NOT BE DISCLOSED, REPRODUCED, OR COPIED IN ANY FORM, INCLUDING IN ELECTRONIC FORM, FOR ANY PURPOSE WITHOUT THE EXPRESS WRITTEN CONSENT OF EVQVOLA. ALL PATENT RIGHTS ARE RESERVED. THIS DOCUMENT AND DERIVATIVE WORKS THEREOF ARE PROTECTED BY PATENT, COPYRIGHT, AND TRADE SECRET LAWS OF EVQVOLA. THIS DOCUMENT, ALONG WITH ALL COPIES AND EXTRACTS, AND ALL RELATED NOTES AND ANALYSES MUST BE RETURNED TO EVQVOLA OR DESTROYED, AS INSTRUCTED BY EVQVOLA, UPON COMPLETION OF THE DELIVERY OF THE DOCUMENTS CONSTITUTING THIS AGREEMENT TO THESE TERMS.

DWN BY: C.HANER	DATE 2024-08-06
CKD BY: K.KALUNG	DATE 2024-08-06
APPD BY: K.KALUNG	DATE 2024-08-06
MGD BY: P.RYAN	SCALE NTS
PART NUMBER W3T625446	

TYPE	ELECTRICAL SCHEMATICS & ENCLOSURE DIAGRAMS (CETLUS) CONTAINER INTERFACE JUNCTION BOX JB-0117				
CLIENT	ELECTRIC HYDROGEN BEAUMONT, TX				
 EVOQUA WATER TECHNOLOGIES		EVOQUA WATER TECHNOLOGIES COLORADO SPRINGS CO USA +1 719-570-9800			
PROJ/PROD NUMBER	2034/001845	CODE	FILE/DRAWING NUMBER	SHEET	REV
		EC-D050	V121057485-09	9 OF 9	0