EVOQUA WATER TECHNOLOGIES

ELECTRIC HYDROGEN
BEAUMONT, TX
PROJECT NUMBER: 2034/001845

EVOQUA MUST IDENTIFY HOW TO GET SHIPPED LOOSE LIT-501 WIRING INTO THE CONEX CONTAINER. HIGHLY ENCOURAGE A NEW JUNCTION BE ADDED OVER THE TOP OF THE POWER DISTRIBUTION PANEL (PDP) FOR LIT-501 AND CUSTOMER CONTROLS INTERFACE CONNECTIONS (4PR #16 & TWO ETHERNET CABLES).

Project No.:	**22MH194**
P.O. No.:	**8027** **Tag No.:**

1	Approved Without Comments
2	Approved With Comments; Revise and Resubmit
3	Revise and Resubmit
4	For Information Only
5	Certified as Final Data

Ron Perego — Project Manager — 6/17/24 Date

Bart Rajtar — Project Engineer — 6/17/24 Date

EH2 Representative — Date

SHEET	PART NUMBER	FILENAME/DRAWING	DRAWING DESCRIPTION
1	W3T602505	V112057484-01	COVER SHEET
2	W3T602505	V112057484-02	ELECTRICAL SCHEMATIC NOTES
3	W3T602505	V112057484-03	POWER DISTRIBUTION - 120VAC
4	W3T602505	V112057484-04	PLC COMMUNICATION & CONTROL CIRCUIT - 24VDC
5	W3T602505	V112057484-05	DIGITAL INPUT
6	W3T602505	V112057484-06	DIGITAL INPUT
7	W3T602505	V112057484-07	BLANK SHEET
8	W3T602505	V112057484-08	ANALOG INPUT
9	W3T602505	V112057484-09	ANALOG INPUT
10	W3T602505	V112057484-10	ANALOG INPUT
11	W3T602505	V112057484-11	DIGITAL OUTPUT
12	W3T602505	V112057484-12	DIGITAL OUTPUT
13	W3T602505	V112057484-13	ANALOG INPUT
14	W3T602505	V112057484-14	UV SCHEME
15	W3T602505	V112057484-15	PUMP & TDC SCHEME
16	W3T602505	V112057484-16	ELECTRICAL ENCLOSURE EXTERIOR
17	W3T602505	V112057484-17	ELECTRICAL ENCLOSURE CUTOUT
18	W3T602505	V112057484-18	ELECTRICAL ENCLOSURE SUB PANEL LAYOUT
19	W3T602505	V112057484-19	ELECTRICAL TERMINAL LAYOUT
20	W3T602505	V112057484-20	ELECTRICAL NAME PLATE SCHEDULE

REV	DESCRIPTION	DATE	DWN	CKD	APPD	ECN
2	REVISE SCHEMATIC NOTE #3	2024-05-14	C.HANER	K.KALUNG	K.KALUNG	ECM127665
1	ISSUED FOR CONSTRUCTION	2024-03-26	M.KALIRA	K.KISITU	K.KISITU	-
0	ISSUED FOR CONSTRUCTION	2023-12-28	M.KALIRA	S.THANGA	K.KISITU	N/A

COMPANY CONFIDENTIAL INFORMATION
THIS DOCUMENT AND ALL INFORMATION CONTAINED HEREIN, INCLUDING THE DESIGN CONCEPTS AND THOSE ARISING THEREFROM, ARE THE PROPERTY OF EVOQUA AND/OR ITS AFFILIATES AND ARE SUBMITTED IN CONFIDENCE. THEY MAY BE USED ONLY FOR THE EXPRESS PURPOSE FOR WHICH THEY ARE PROVIDED AND MUST NOT BE DISCLOSED, REPRODUCED, OR COPIED IN ANY FORM, INCLUDING IN ELECTRONIC FORMAT, LOANED OR USED IN ANY OTHER MANNER WITHOUT THE EXPRESS WRITTEN CONSENT OF EVOQUA. ALL PATENT RIGHTS ARE RESERVED. THIS DOCUMENT AND DERIVATIVE WORKS THEREOF ARE PROTECTED UNDER APPLICABLE COPYRIGHT LAWS. UPON DEMAND OF EVOQUA, THIS DOCUMENT, ALONG WITH ALL COPIES AND EXTRACTS, AND ALL RELATED NOTES AND ANALYSES MUST BE RETURNED TO EVOQUA OR DESTROYED, AS INSTRUCTED BY EVOQUA. ACCEPTANCE OF THE DELIVERY OF THIS DOCUMENT CONSTITUTES AGREEMENT TO THESE TERMS.

DWN BY:	M.KALIRA	DATE	2023-12-11
CKD BY:	S.THANGA	DATE	2023-12-11
APPD BY:	K.KISITU	DATE	2023-12-11
MGD BY:	P.RYAN	SCALE	NTS

TITLE: ELECTRICAL SCHEMATICS & ENCLOSURE DIAGRAMS (cETLus)
CONTAINERIZED 2-PASS RO WITH PRETREATMENT
RIO PANEL

CLIENT: ELECTRIC HYDROGEN
BEAUMONT, TX

EVOQUA WATER TECHNOLOGIES
COLORADO SPRINGS CO USA
+1 719-570-9600

PART NUMBER	PROJ/PROD NUMBER	CODE	FILE/DRAWING NUMBER	SHEET	REV
W3T602505	2034/001845	EC-DOS03	V112057484-01	1 OF 20	2

STD Electrical v4.3 — BAR = 1" AT PLOT SCALE

ELECTRICAL SCHEMATIC NOTES

NOTES: UNLESS OTHERWISE SPECIFIED

1. ALL INTERNAL PANEL WIRING TO BE #14 AWG EXCEPT CLASS 2 CONTROL CIRCUITS AND PLC I/O TO BE #18 AWG.

2. ┌─ · ─ · ─┐ DENOTES REMOTE PANELS OR COMPONENT(S).

3. ALL FIELD WIRING TO BE COPPER CONDUCTORS SIZED AT MIN 60°C.

4. --s---s-- DENOTES SKID WIRING BY FACTORY.

5. -------- DENOTES FIELD WIRING TO EXTERNAL COMPONENTS (BY OTHERS).

6. WIRE COLORS:

BLK	120/230V AND ABOVE POWER
RED	120/230V CONTROL
WHT	NEUTRAL
BLU	DC POSITIVE
BLU/WHT	DC UNGROUNDED COMMON
WHT/BLU	DC GROUNDED COMMON
ORG	EXTERNALLY POWERED OR UNGROUNDED CONDUCTORS REMAINING ENERGIZED WHEN MAIN SUPPLY CIRCUIT DISCONNECT IS IN OFF POSITION
WHT/ORG	GROUNDED AC CIRCUIT CONDUCTOR REMAINING ENERGIZED WHEN MAIN SUPPLY CIRCUIT DISCONNECT IS IN OFF POSITION
GRN/YEL	GROUNDING

7. ALL SKID WIRING TO BE #14 AWG THHN MINIMUM, EXCEPT FOR MULTI-CONDUCTOR CABLES WITH OVERALL JACKET.

8. SHIELDED SIGNAL CABLE FOR CLASS 1 CONTROL CIRCUITS TO BE 600V BELDEN 1120A OR EQUIVALENT.

9. SHIELDED SIGNAL CABLE FOR CLASS 2 CONTROL CIRCUITS TO BE 300V BELDEN 8760 OR EQUIVALENT.

10. --c---c--DENOTES CONTAINER WIRING BY FACTORY.

REV	DESCRIPTION	DATE	DWN	CKD	APPD	ECN
2	REVISE SCHEMATIC NOTE #3	2024-05-14	C.HANER	K.KALUNG	K.KALUNG	ECM127665
1	ISSUED FOR CONSTRUCTION	2024-03-26	M.KALIRA	K.KISITU	K.KISITU	-
0	ISSUED FOR CONSTRUCTION	2023-12-28	M.KALIRA	S.THANGA	K.KISITU	N/A

COMPANY CONFIDENTIAL INFORMATION
THIS DOCUMENT AND ALL INFORMATION CONTAINED HEREIN, INCLUDING THE DESIGN CONCEPTS AND THOSE ARISING THEREFROM, ARE THE PROPERTY OF EVOQUA AND/OR ITS AFFILIATES AND ARE SUBMITTED IN CONFIDENCE. THEY MAY BE USED ONLY FOR THE EXPRESS PURPOSE FOR WHICH THEY ARE PROVIDED AND MUST NOT BE DISCLOSED, REPRODUCED, OR COPIED IN ANY FORM, INCLUDING IN ELECTRONIC FORMAT, LOANED OR USED IN ANY OTHER MANNER WITHOUT THE PRIOR WRITTEN PERMISSION OF EVOQUA. ALL PATENT RIGHTS ARE RESERVED. THIS DOCUMENT AND DERIVATIVE WORKS THEREOF ARE PROTECTED UNDER APPLICABLE COPYRIGHT LAWS. UPON DEMAND OF EVOQUA, THIS DOCUMENT, ALONG WITH ALL COPIES AND EXTRACTS, AND ALL RELATED NOTES AND ANALYSES MUST BE RETURNED TO EVOQUA OR DESTROYED, AS INSTRUCTED BY EVOQUA. ACCEPTANCE OF THE DELIVERY OF THIS DOCUMENT CONSTITUTES AGREEMENT TO THESE TERMS.

DWN BY: M.KALIRA	DATE 2023-12-11
CKD BY: S.THANGA	DATE 2023-12-11
APPD BY: K.KISITU	DATE 2023-12-11
MGD BY: P.RYAN	SCALE NTS
PART NUMBER W3T602505	

TITLE: ELECTRICAL SCHEMATICS & ENCLOSURE DIAGRAMS (cETLus)
CONTAINERIZED 2-PASS RO WITH PRETREATMENT
RIO PANEL

CLIENT: ELECTRIC HYDROGEN
BEAUMONT, TX

EVOQUA WATER TECHNOLOGIES
COLORADO SPRINGS CO USA
+1 719-570-9600

PROJ/PROD NUMBER	CODE	FILE/DRAWING NUMBER	SHEET	REV
2034/001845	EC-DOS03	V112057484-02	2 OF 20	2

STD: Electrical v4.3 | BAR = 1" AT PLOT SCALE

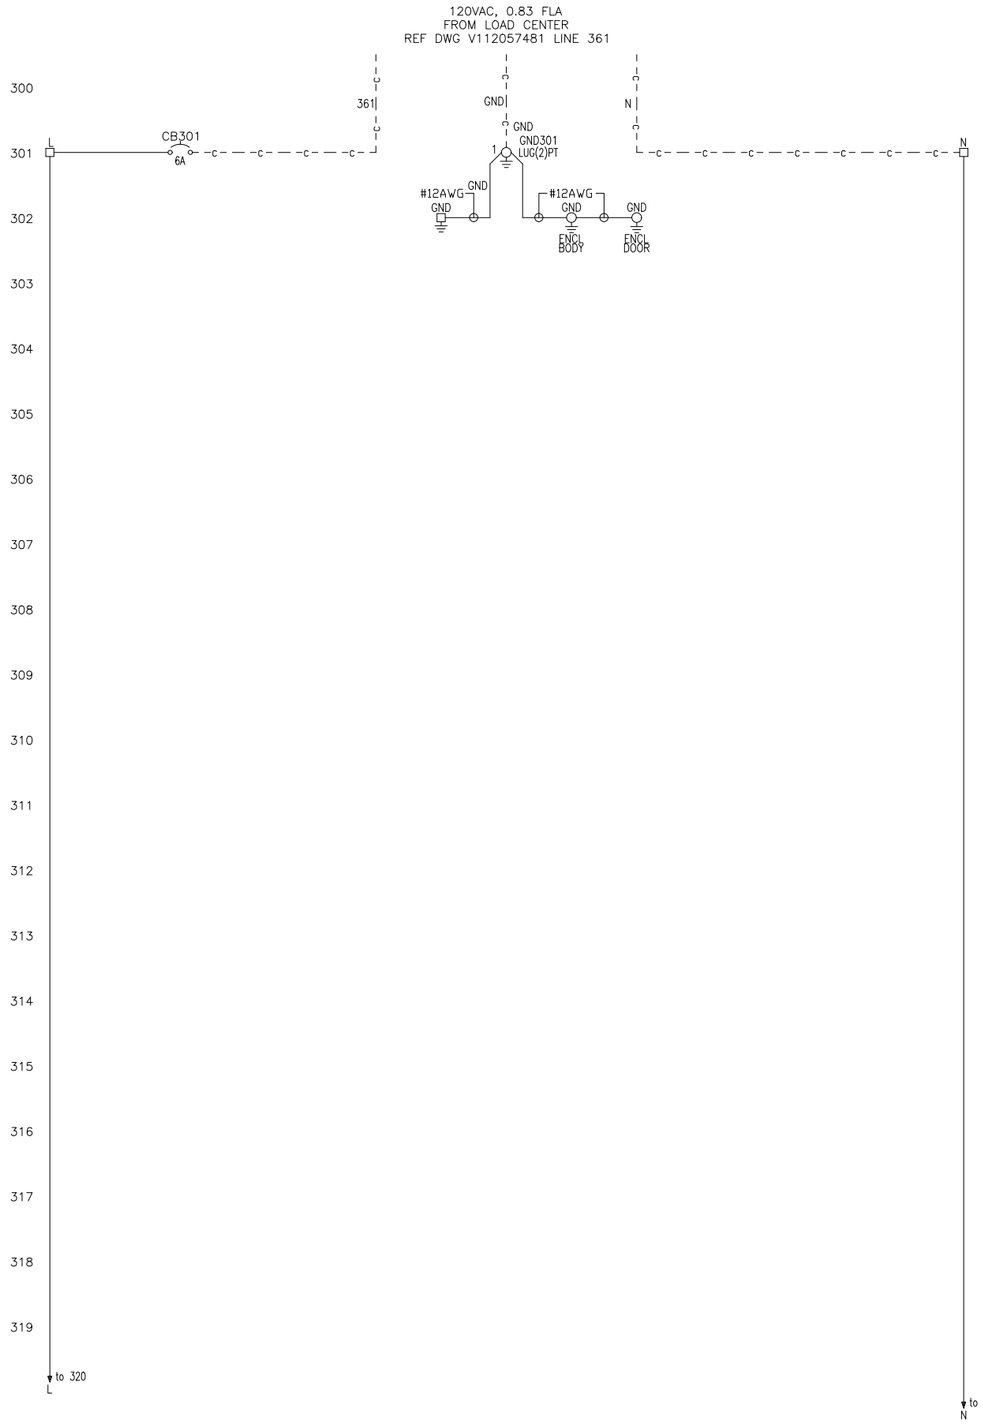

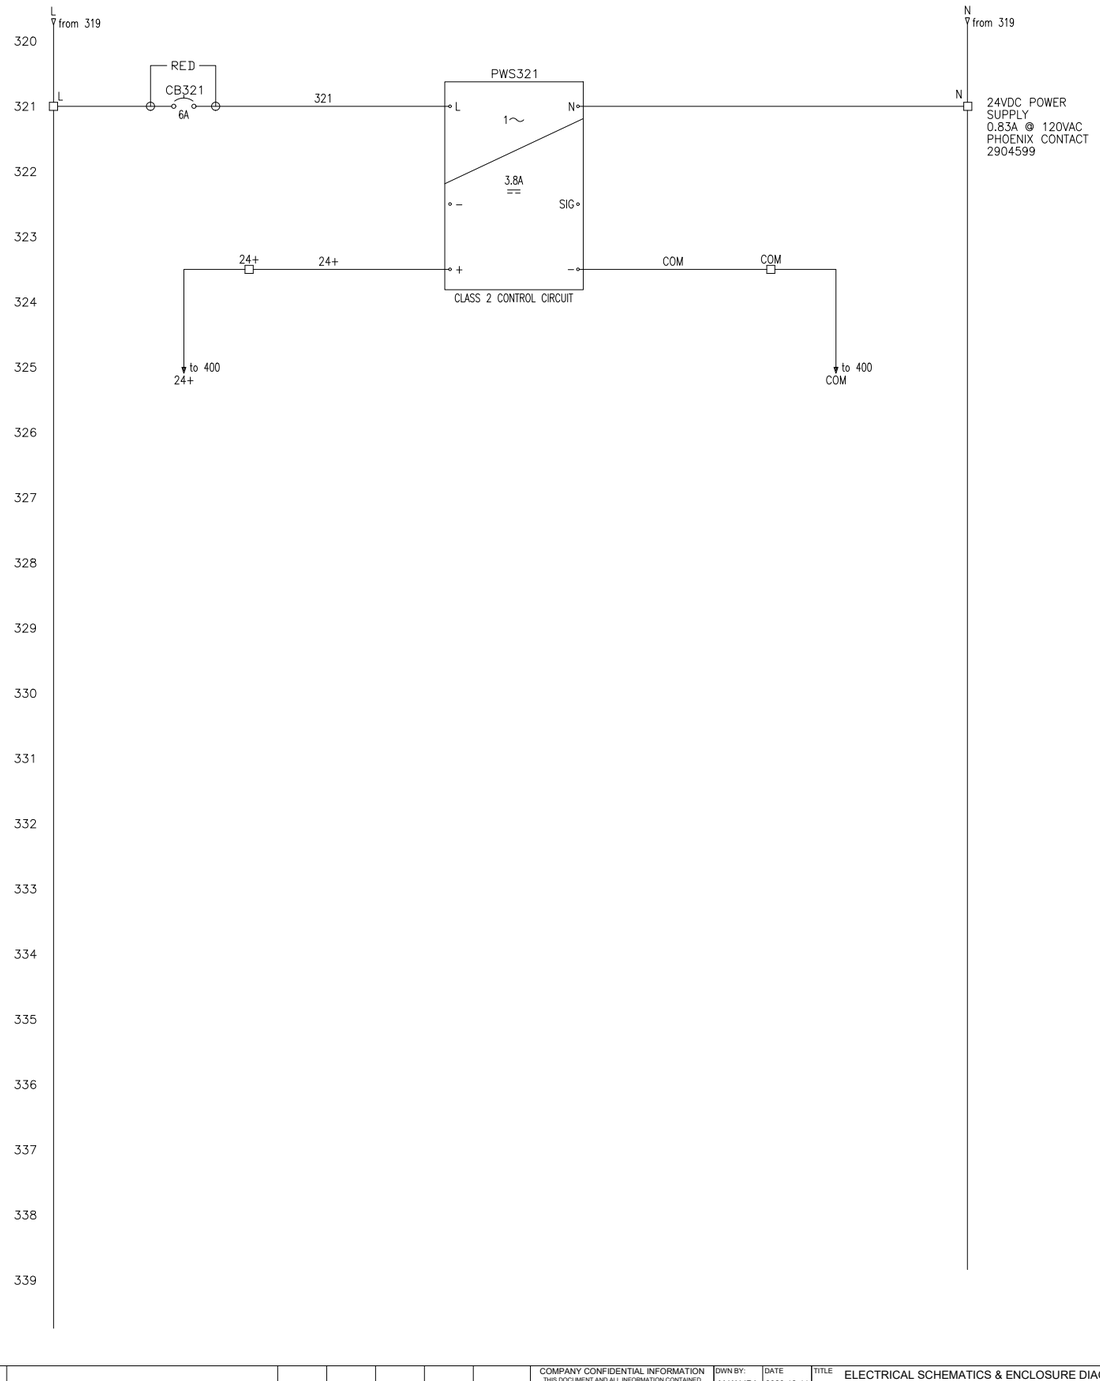

BAR = 1" AT PLOT SCALE

STD: Electrical v4.3

REV	DESCRIPTION	DATE	DWN	CKD	APPD	ECN
2	REVISE SCHEMATIC NOTE #3	2024-05-14	C.HANER	K.KALUNG	K.KALUNG	ECM127665
1	ISSUED FOR CONSTRUCTION	2024-03-26	M.KALIRA	K.KISITU	K.KISITU	-
0	ISSUED FOR CONSTRUCTION	2023-12-28	M.KALIRA	S.THANGA	K.KISITU	N/A

COMPANY CONFIDENTIAL INFORMATION
THIS DOCUMENT AND ALL INFORMATION CONTAINED HEREIN, INCLUDING THE DESIGN CONCEPTS AND THOSE ARISING THEREFROM, ARE THE PROPERTY OF EVOQUA AND/OR ITS AFFILIATES AND ARE SUBMITTED IN CONFIDENCE. THEY MAY BE USED ONLY FOR THE EXPRESS PURPOSE FOR WHICH THEY ARE PROVIDED AND MUST NOT BE DISCLOSED, REPRODUCED, OR COPIED IN ANY FORM, INCLUDING IN ELECTRONIC FORMAT, LOANED OR USED IN ANY OTHER MANNER WITHOUT THE PRIOR WRITTEN CONSENT OF EVOQUA. ALL PATENT RIGHTS ARE RESERVED. THIS DOCUMENT AND DERIVATIVE WORKS THEREOF ARE PROTECTED UNDER APPLICABLE COPYRIGHT LAWS. UPON DEMAND OF EVOQUA, THIS DOCUMENT, ALONG WITH ALL COPIES AND EXTRACTS, AND ALL RELATED NOTES AND ANALYSES MUST BE RETURNED TO EVOQUA OR DESTROYED, AS INSTRUCTED BY EVOQUA. ACCEPTANCE OF THE DELIVERY OF THIS DOCUMENT CONSTITUTES AGREEMENT TO THESE TERMS.

DWN BY: M.KALIRA	DATE 2023-12-11
CKD BY: S.THANGA	DATE 2023-12-11
APPD BY: K.KISITU	DATE 2023-12-11
MGD BY: P.RYAN	SCALE NTS
PART NUMBER W3T602505	

TITLE: ELECTRICAL SCHEMATICS & ENCLOSURE DIAGRAMS (cETLus)
CONTAINERIZED 2-PASS RO WITH PRETREATMENT
RIO PANEL

CLIENT: ELECTRIC HYDROGEN
BEAUMONT, TX

EVOQUA WATER TECHNOLOGIES
COLORADO SPRINGS CO USA
+1 719-570-9600

PROJ/PROD NUMBER	CODE	FILE/DRAWING NUMBER	SHEET	REV
2034/001845	EC-DOS03	V112057484-03	3 OF 20	2

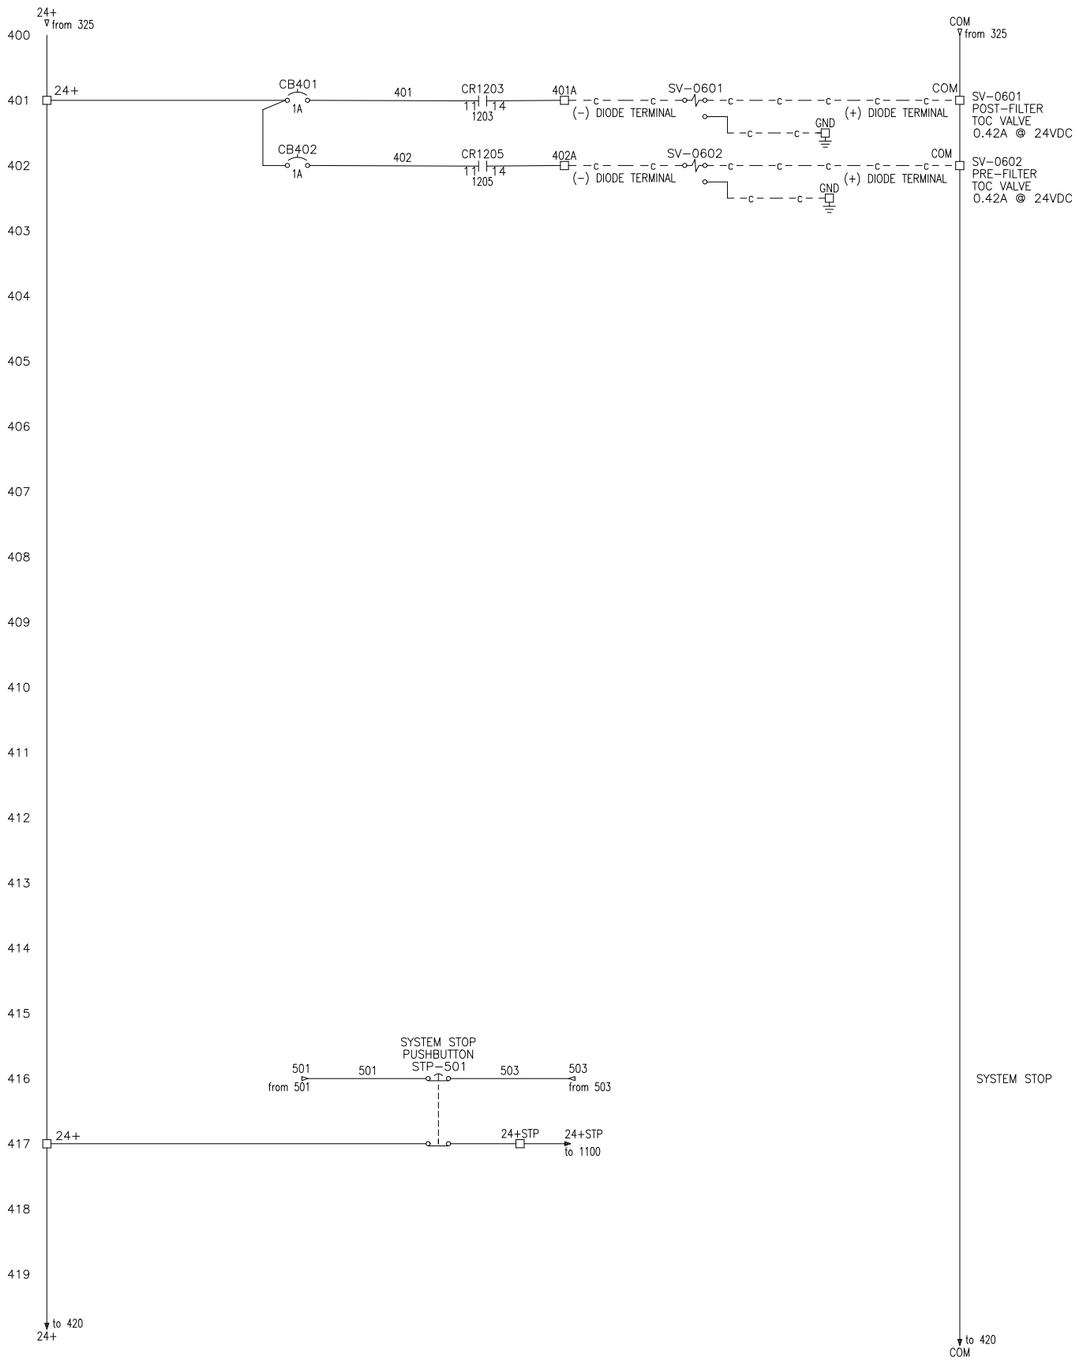

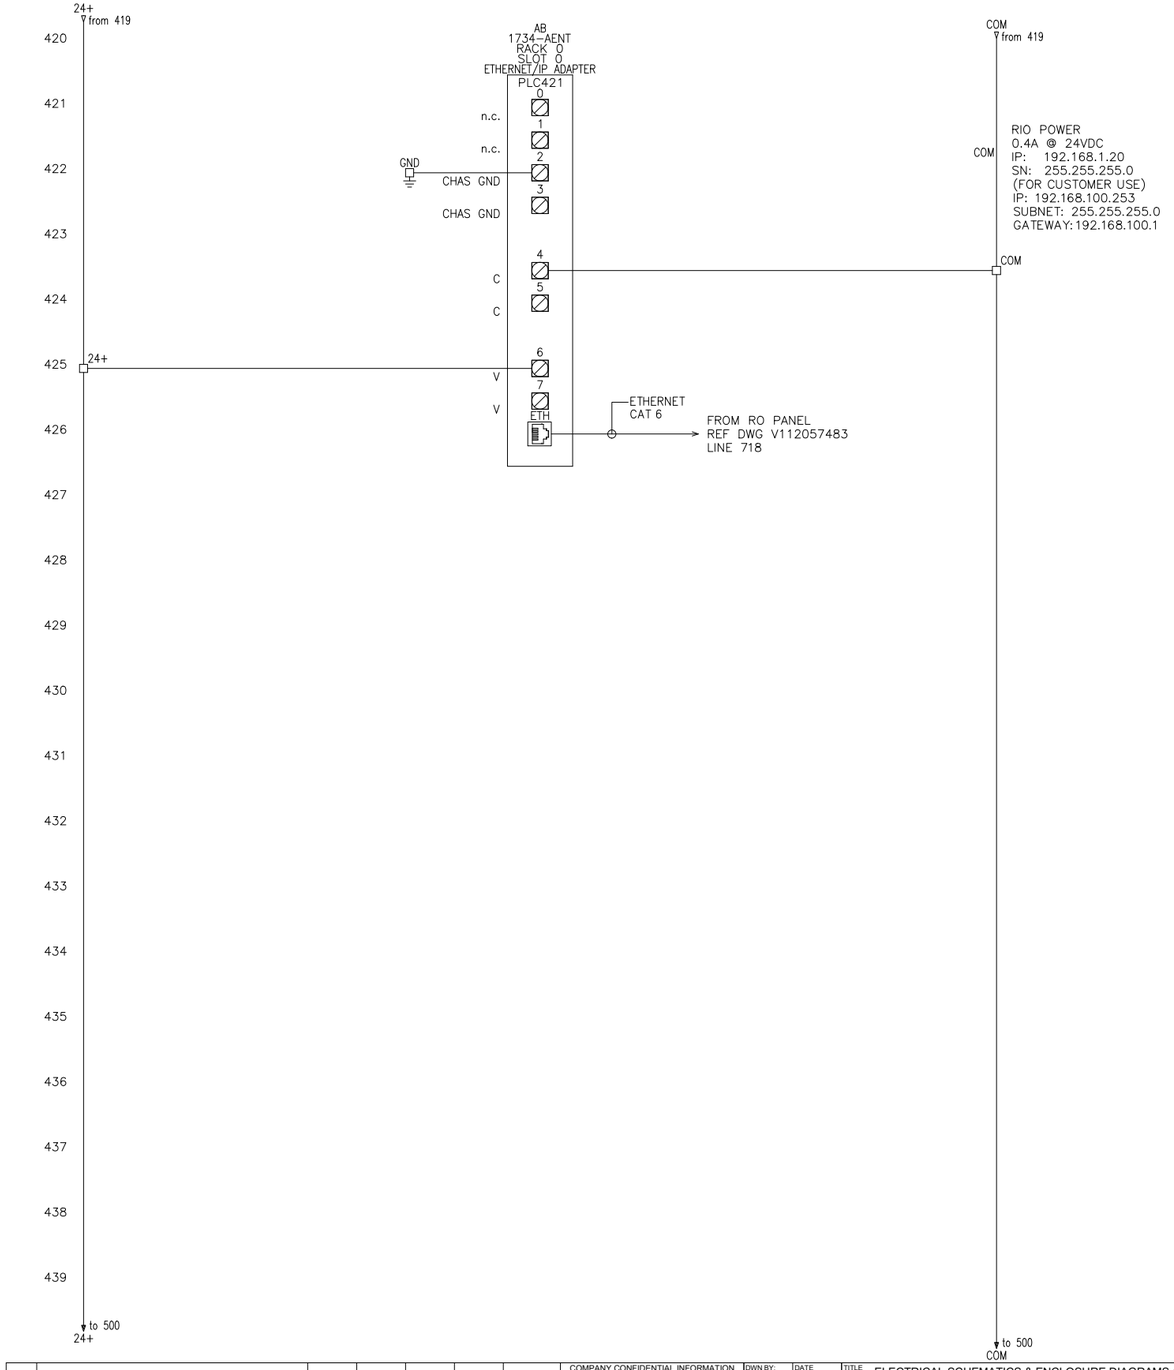

REV	DESCRIPTION	DATE	DWN	CKD	APPD	ECN
2	REVISE SCHEMATIC NOTE #3	2024-05-14	C.HANER	K.KALUNG	K.KALUNG	ECM127665
1	ISSUED FOR CONSTRUCTION	2024-03-26	M.KALIRA	K.KISITU	K.KISITU	-
0	ISSUED FOR CONSTRUCTION	2023-12-28	M.KALIRA	S.THANGA	K.KISITU	N/A

COMPANY CONFIDENTIAL INFORMATION
THIS DOCUMENT AND ALL INFORMATION CONTAINED HEREIN, INCLUDING THE DESIGN CONCEPTS AND THOSE ARISING THEREFROM, ARE THE PROPERTY OF EVOQUA AND/OR ITS AFFILIATES AND ARE SUBMITTED IN CONFIDENCE. THEY MAY BE USED ONLY FOR THE EXPRESS PURPOSE FOR WHICH THEY ARE PROVIDED AND MUST NOT BE DISCLOSED, REPRODUCED, OR COPIED IN ANY FORM, INCLUDING IN ELECTRONIC FORMAT, LOANED OR USED IN ANY OTHER MANNER WITHOUT THE PRIOR WRITTEN CONSENT OF EVOQUA. ALL PATENT RIGHTS ARE RESERVED. THIS DOCUMENT AND DERIVATIVE WORKS THEREOF ARE PROTECTED UNDER APPLICABLE COPYRIGHT LAWS. UPON DEMAND OF EVOQUA, THIS DOCUMENT, ALONG WITH ALL COPIES AND EXTRACTS, AND ALL RELATED NOTES AND ANALYSES MUST BE RETURNED TO EVOQUA OR DESTROYED, AS INSTRUCTED BY EVOQUA. ACCEPTANCE OF THE DELIVERY OF THIS DOCUMENT CONSTITUTES AGREEMENT TO THESE TERMS.

DWN BY: M.KALIRA	DATE 2023-12-11
CKD BY: S.THANGA	DATE 2023-12-11
APPD BY: K.KISITU	DATE 2023-12-11
MGD BY: P.RYAN	SCALE NTS
PART NUMBER	W3T602505

TITLE: ELECTRICAL SCHEMATICS & ENCLOSURE DIAGRAMS (cETLus)
CONTAINERIZED 2-PASS RO WITH PRETREATMENT
RIO PANEL

CLIENT: ELECTRIC HYDROGEN
BEAUMONT, TX

EVOQUA WATER TECHNOLOGIES
COLORADO SPRINGS CO USA
+1 719-570-9600

PROJ/PROD NUMBER	CODE	FILE/DRAWING NUMBER	SHEET	REV
2034/001845	EC-DOS03	V112057484-04	4 OF 20	2

STD: Electrical v4.3
BAR = 1" AT PLOT SCALE

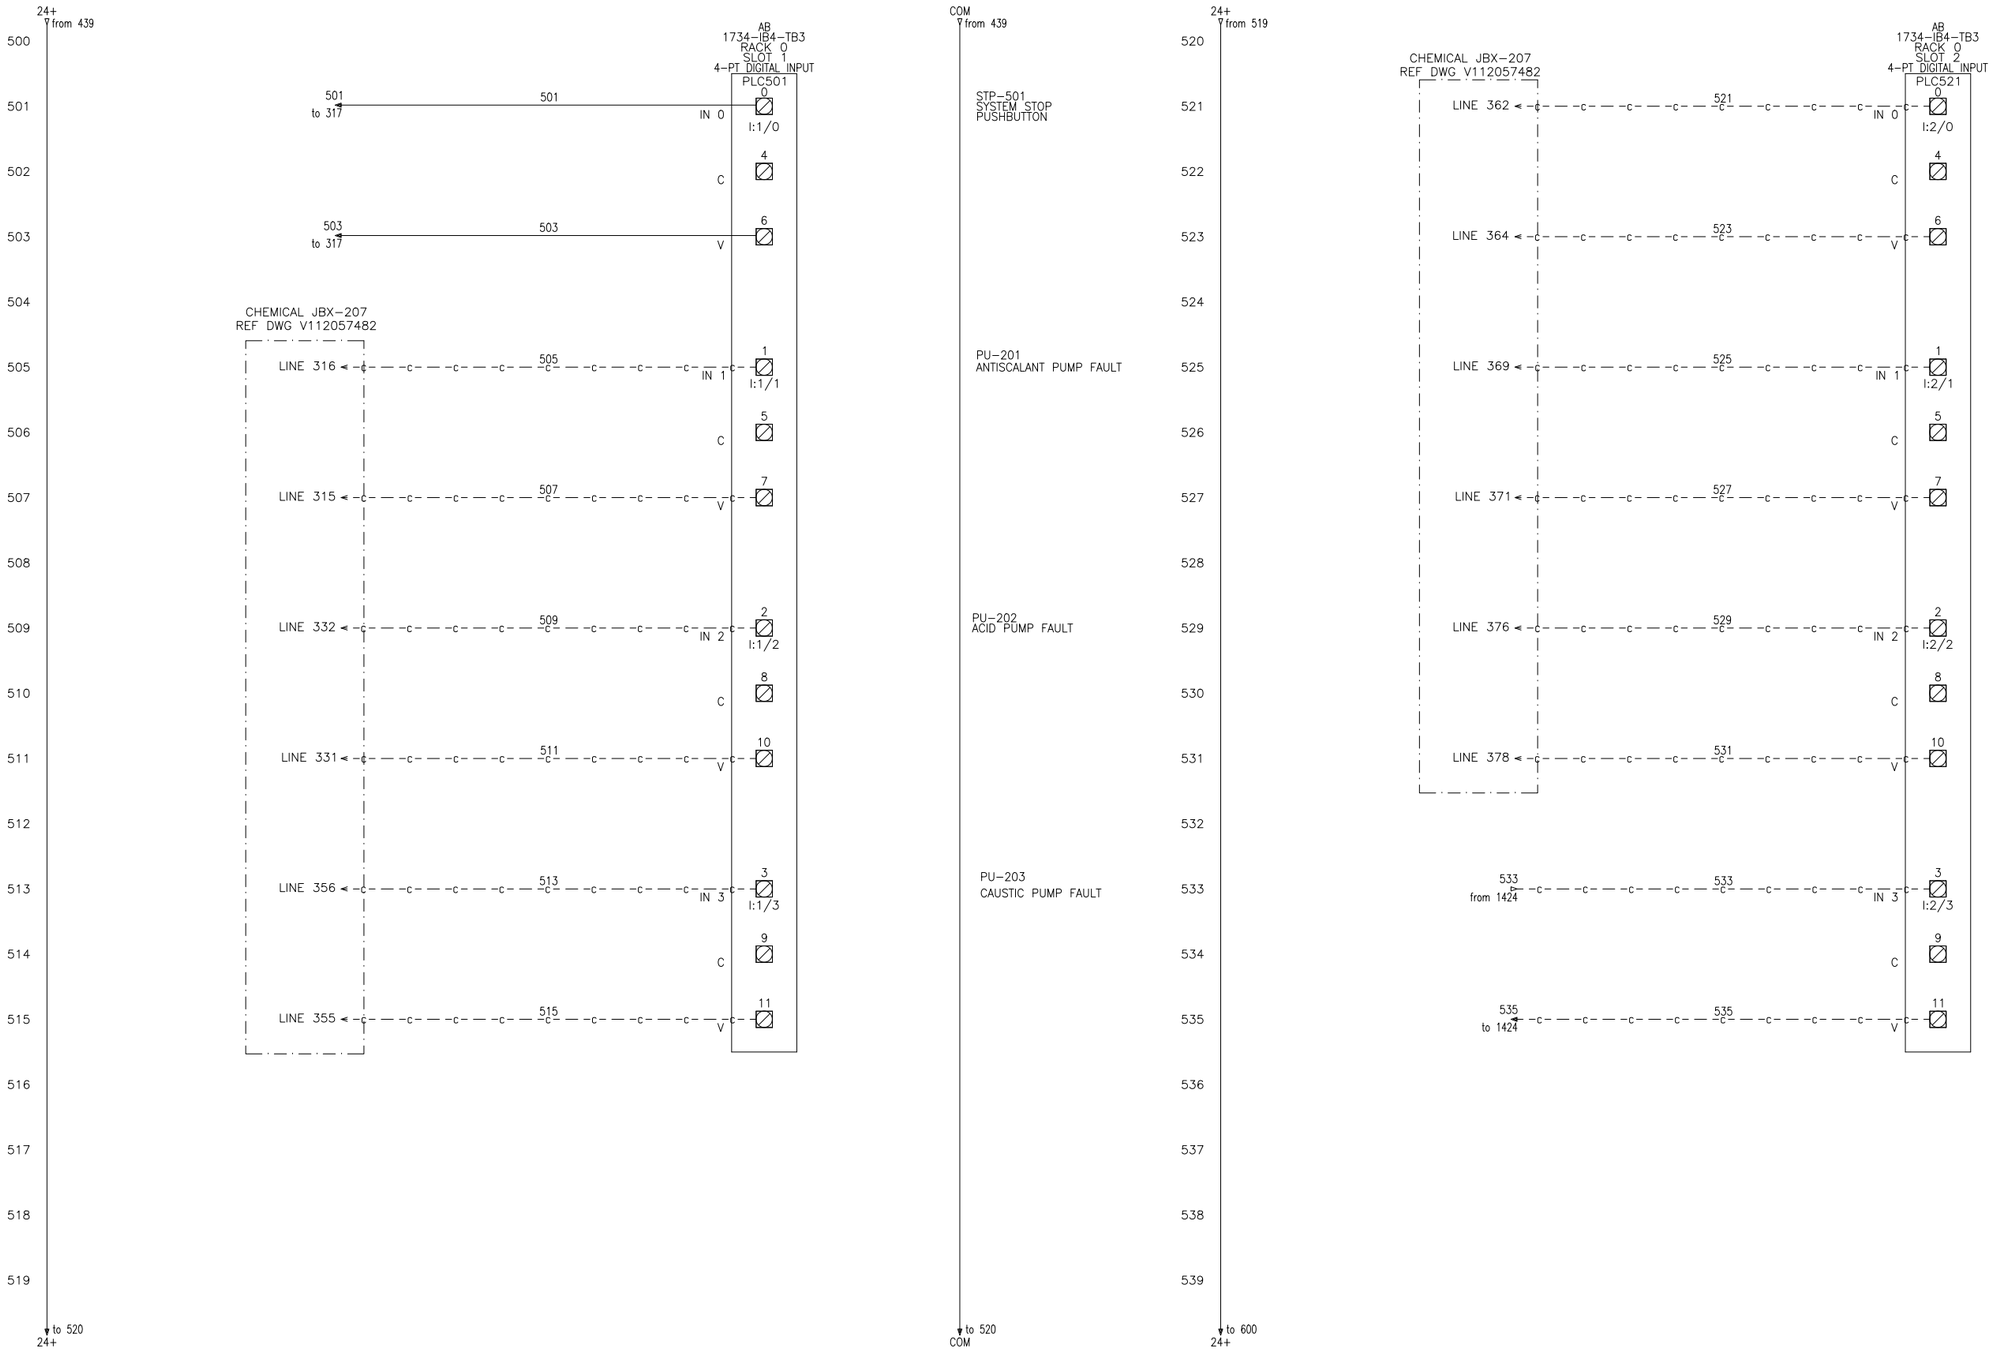

BAR = 1" AT PLOT SCALE

STD_Electrical_v4.3

REV	DESCRIPTION	DATE	DWN	CKD	APPD	ECN
2	REVISE SCHEMATIC NOTE #3	2024-05-14	C.HANER	K.KALUNG	K.KALUNG	ECM127665
1	ISSUED FOR CONSTRUCTION	2024-03-26	M.KALIRA	K.KISITU	K.KISITU	-
0	ISSUED FOR CONSTRUCTION	2023-12-28	M.KALIRA	S.THANGA	K.KISITU	N/A

COMPANY CONFIDENTIAL INFORMATION
THIS DOCUMENT AND ALL INFORMATION CONTAINED HEREIN, INCLUDING THE DESIGN CONCEPTS AND THOSE ARISING THEREFROM, ARE THE PROPERTY OF EVOQUA AND/OR ITS AFFILIATES AND ARE SUBMITTED IN CONFIDENCE. THEY MAY BE USED ONLY FOR THE EXPRESS PURPOSE FOR WHICH THEY ARE PROVIDED AND MUST NOT BE DISCLOSED, REPRODUCED, OR COPIED IN ANY FORM, INCLUDING IN ELECTRONIC FORMAT, LOANED OR USED IN ANY OTHER MANNER WITHOUT THE PRIOR WRITTEN CONSENT OF EVOQUA. ALL PATENT RIGHTS ARE RESERVED. THIS DOCUMENT AND DERIVATIVE WORKS THEREOF ARE PROTECTED UNDER APPLICABLE COPYRIGHT LAWS. UPON DEMAND OF EVOQUA, THIS DOCUMENT, ALONG WITH ALL COPIES AND EXTRACTS, AND ALL RELATED NOTES AND ANALYSES MUST BE RETURNED TO EVOQUA OR DESTROYED, AS INSTRUCTED BY EVOQUA. ACCEPTANCE OF THE DELIVERY OF THIS DOCUMENT CONSTITUTES AGREEMENT TO THESE TERMS.

DWN BY: M.KALIRA	DATE 2023-12-11
CKD BY: S.THANGA	DATE 2023-12-11
APPD BY: K.KISITU	DATE 2023-12-11
MGD BY: P.RYAN	SCALE NTS
PART NUMBER W3T602505	

TITLE: ELECTRICAL SCHEMATICS & ENCLOSURE DIAGRAMS (cETLus)
CONTAINERIZED 2-PASS RO WITH PRETREATMENT
RIO PANEL

CLIENT: ELECTRIC HYDROGEN
BEAUMONT, TX

evoqua WATER TECHNOLOGIES
EVOQUA WATER TECHNOLOGIES
COLORADO SPRINGS CO USA
+1 719-570-9600

PROJ/PROD NUMBER	CODE	FILE/DRAWING NUMBER	SHEET	REV
2034/001845	EC-DOS03	V112057484-05	5 OF 20	2

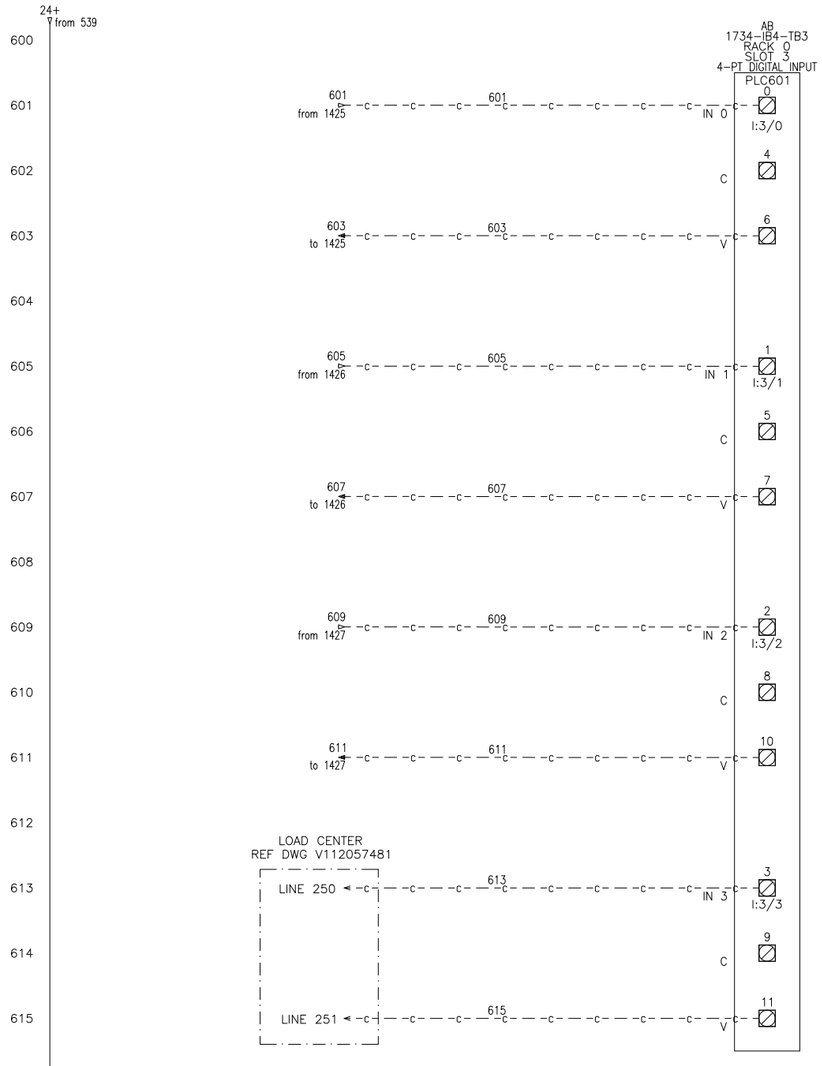

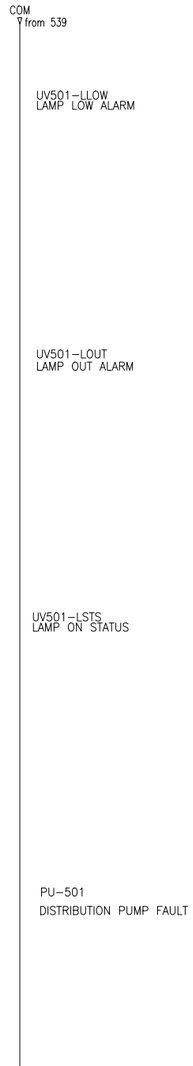

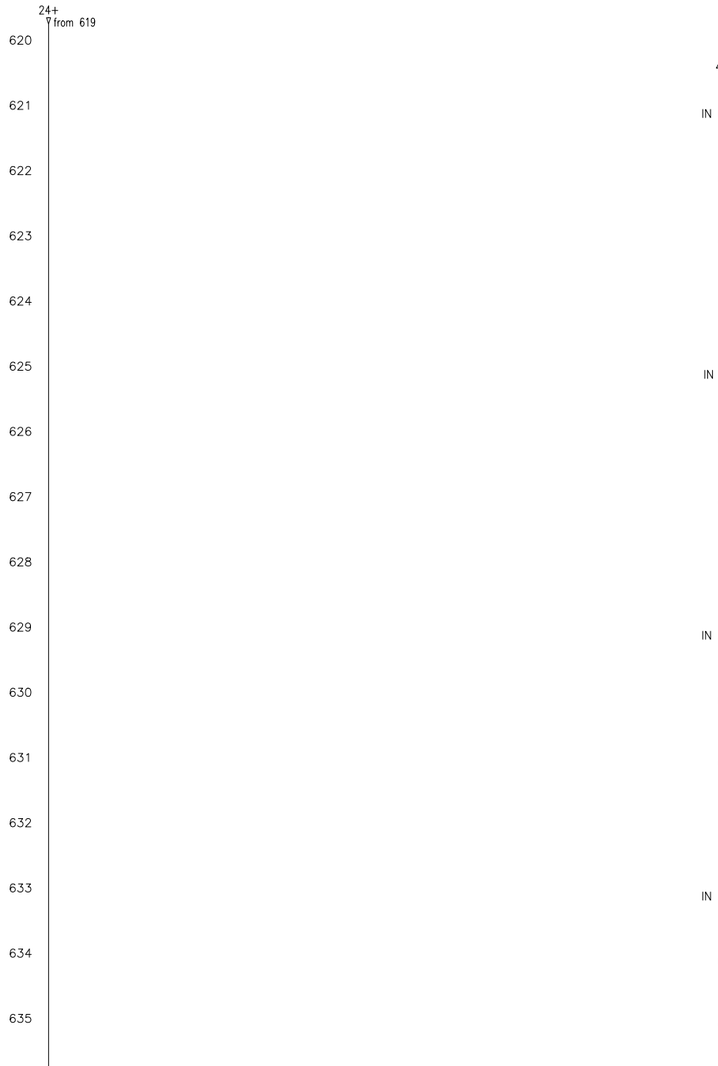

D
C
B
A

STD: Electrical v4.3

BAR = 1" AT PLOT SCALE

REV	DESCRIPTION	DATE	DWN	CKD	APPD	ECN
2	REVISE SCHEMATIC NOTE #3	2024-05-14	C.HANER	K.KALUNG	K.KALUNG	ECM127665
1	ISSUED FOR CONSTRUCTION	2024-03-26	M.KALIRA	K.KISITU	K.KISITU	-
0	ISSUED FOR CONSTRUCTION	2023-12-28	M.KALIRA	S.THANGA	K.KISITU	N/A

COMPANY CONFIDENTIAL INFORMATION
THIS DOCUMENT AND ALL INFORMATION CONTAINED HEREIN, INCLUDING THE DESIGN CONCEPTS AND THOSE ARISING THEREFROM, ARE THE PROPERTY OF EVOQUA AND/OR ITS AFFILIATES AND ARE SUBMITTED IN CONFIDENCE. THEY MAY BE USED ONLY FOR THE EXPRESS PURPOSE FOR WHICH THEY ARE PROVIDED AND MUST NOT BE DISCLOSED, REPRODUCED, OR COPIED IN ANY FORM, INCLUDING IN ELECTRONIC FORMAT, LOADED OR USED IN ANY OTHER MANNER WITHOUT THE PRIOR WRITTEN PERMISSION OF EVOQUA. ALL PATENT RIGHTS ARE RESERVED. THIS DOCUMENT AND DERIVATIVE WORKS THEREOF ARE PROTECTED UNDER APPLICABLE COPYRIGHT LAWS. UPON DEMAND OF EVOQUA, THIS DOCUMENT, ALONG WITH ALL COPIES AND EXTRACTS, AND ALL RELATED NOTES AND ANALYSES MUST BE RETURNED TO EVOQUA OR DESTROYED, AS INSTRUCTED BY EVOQUA. ACCEPTANCE OF THE DELIVERY OF THIS DOCUMENT CONSTITUTES AGREEMENT TO THESE TERMS.

DWN BY: M.KALIRA	DATE 2023-12-11
CKD BY: S.THANGA	DATE 2023-12-11
APPD BY: K.KISITU	DATE 2023-12-11
MGD BY: P.RYAN	SCALE NTS
PART NUMBER W3T602505	

TITLE: ELECTRICAL SCHEMATICS & ENCLOSURE DIAGRAMS (cETLus)
CONTAINERIZED 2-PASS RO WITH PRETREATMENT
RIO PANEL

CLIENT: ELECTRIC HYDROGEN
BEAUMONT, TX

EVOQUA WATER TECHNOLOGIES
COLORADO SPRINGS CO USA
+1 719-570-9600

PROJ/PROD NUMBER	CODE	FILE/DRAWING NUMBER	SHEET	REV
2034/001845	EC-DOS03	V112057484-06	6 OF 20	2

24+ from 639

700

701

INTENTIONALLY LEFT BLANK

702

703

704

705

706

707

708

709

710

711

712

713

714

715

716

717

718

719

to 720
24+

COM from 639

to 720
COM

24+ from 719

720

721

INTENTIONALLY LEFT BLANK

722

723

724

725

726

727

728

729

730

731

732

733

734

735

736

737

738

739

to 800
24+

COM from 719

to 800
COM

BAR = 1" AT PLOT SCALE

STD: Electrical v4.3

REV	DESCRIPTION	DATE	DWN	CKD	APPD	ECN
2	REVISE SCHEMATIC NOTE #3	2024-05-14	C.HANER	K.KALUNG	K.KALUNG	ECM127665
1	ISSUED FOR CONSTRUCTION	2024-03-26	M.KALIRA	K.KISITU	K.KISITU	-
0	ISSUED FOR CONSTRUCTION	2023-12-28	M.KALIRA	S.THANGA	K.KISITU	N/A

COMPANY CONFIDENTIAL INFORMATION
THIS DOCUMENT AND ALL INFORMATION CONTAINED HEREIN, INCLUDING THE DESIGN CONCEPTS AND THOSE ARISING THEREFROM, ARE THE PROPERTY OF EVOQUA AND/OR ITS AFFILIATES AND ARE SUBMITTED IN CONFIDENCE. THEY MAY BE USED ONLY FOR THE EXPRESS PURPOSE FOR WHICH THEY ARE PROVIDED AND MUST NOT BE DISCLOSED, REPRODUCED, OR COPIED IN ANY FORM, INCLUDING IN ELECTRONIC FORMAT, LOANED OR USED IN ANY OTHER MANNER WITHOUT THE PRIOR WRITTEN PERMISSION OF EVOQUA. ALL PATENT RIGHTS ARE RESERVED. THIS DOCUMENT AND DERIVATIVE WORKS THEREOF ARE PROTECTED UNDER APPLICABLE COPYRIGHT LAWS. UPON DEMAND OF EVOQUA, THIS DOCUMENT, ALONG WITH ALL COPIES AND EXTRACTS, AND ALL RELATED NOTES AND ANALYSES MUST BE RETURNED TO EVOQUA OR DESTROYED, AS INSTRUCTED BY EVOQUA. ACCEPTANCE OF THE DELIVERY OF THIS DOCUMENT CONSTITUTES AGREEMENT TO THESE TERMS.

DWN BY: M.KALIRA	DATE 2023-12-11
CKD BY: S.THANGA	DATE 2023-12-11
APPD BY: K.KISITU	DATE 2023-12-11
MGD BY: P.RYAN	SCALE NTS
PART NUMBER W3T602505	

TITLE: ELECTRICAL SCHEMATICS & ENCLOSURE DIAGRAMS (cETLus)
CONTAINERIZED 2-PASS RO WITH PRETREATMENT
RIO PANEL

CLIENT: ELECTRIC HYDROGEN
BEAUMONT, TX

EVOQUA WATER TECHNOLOGIES
COLORADO SPRINGS CO USA
+1 719-570-9600

PROJ/PROD NUMBER	CODE	FILE/DRAWING NUMBER	SHEET	REV
2034/001845	EC-DOS03	V112057484-07	7 OF 20	2

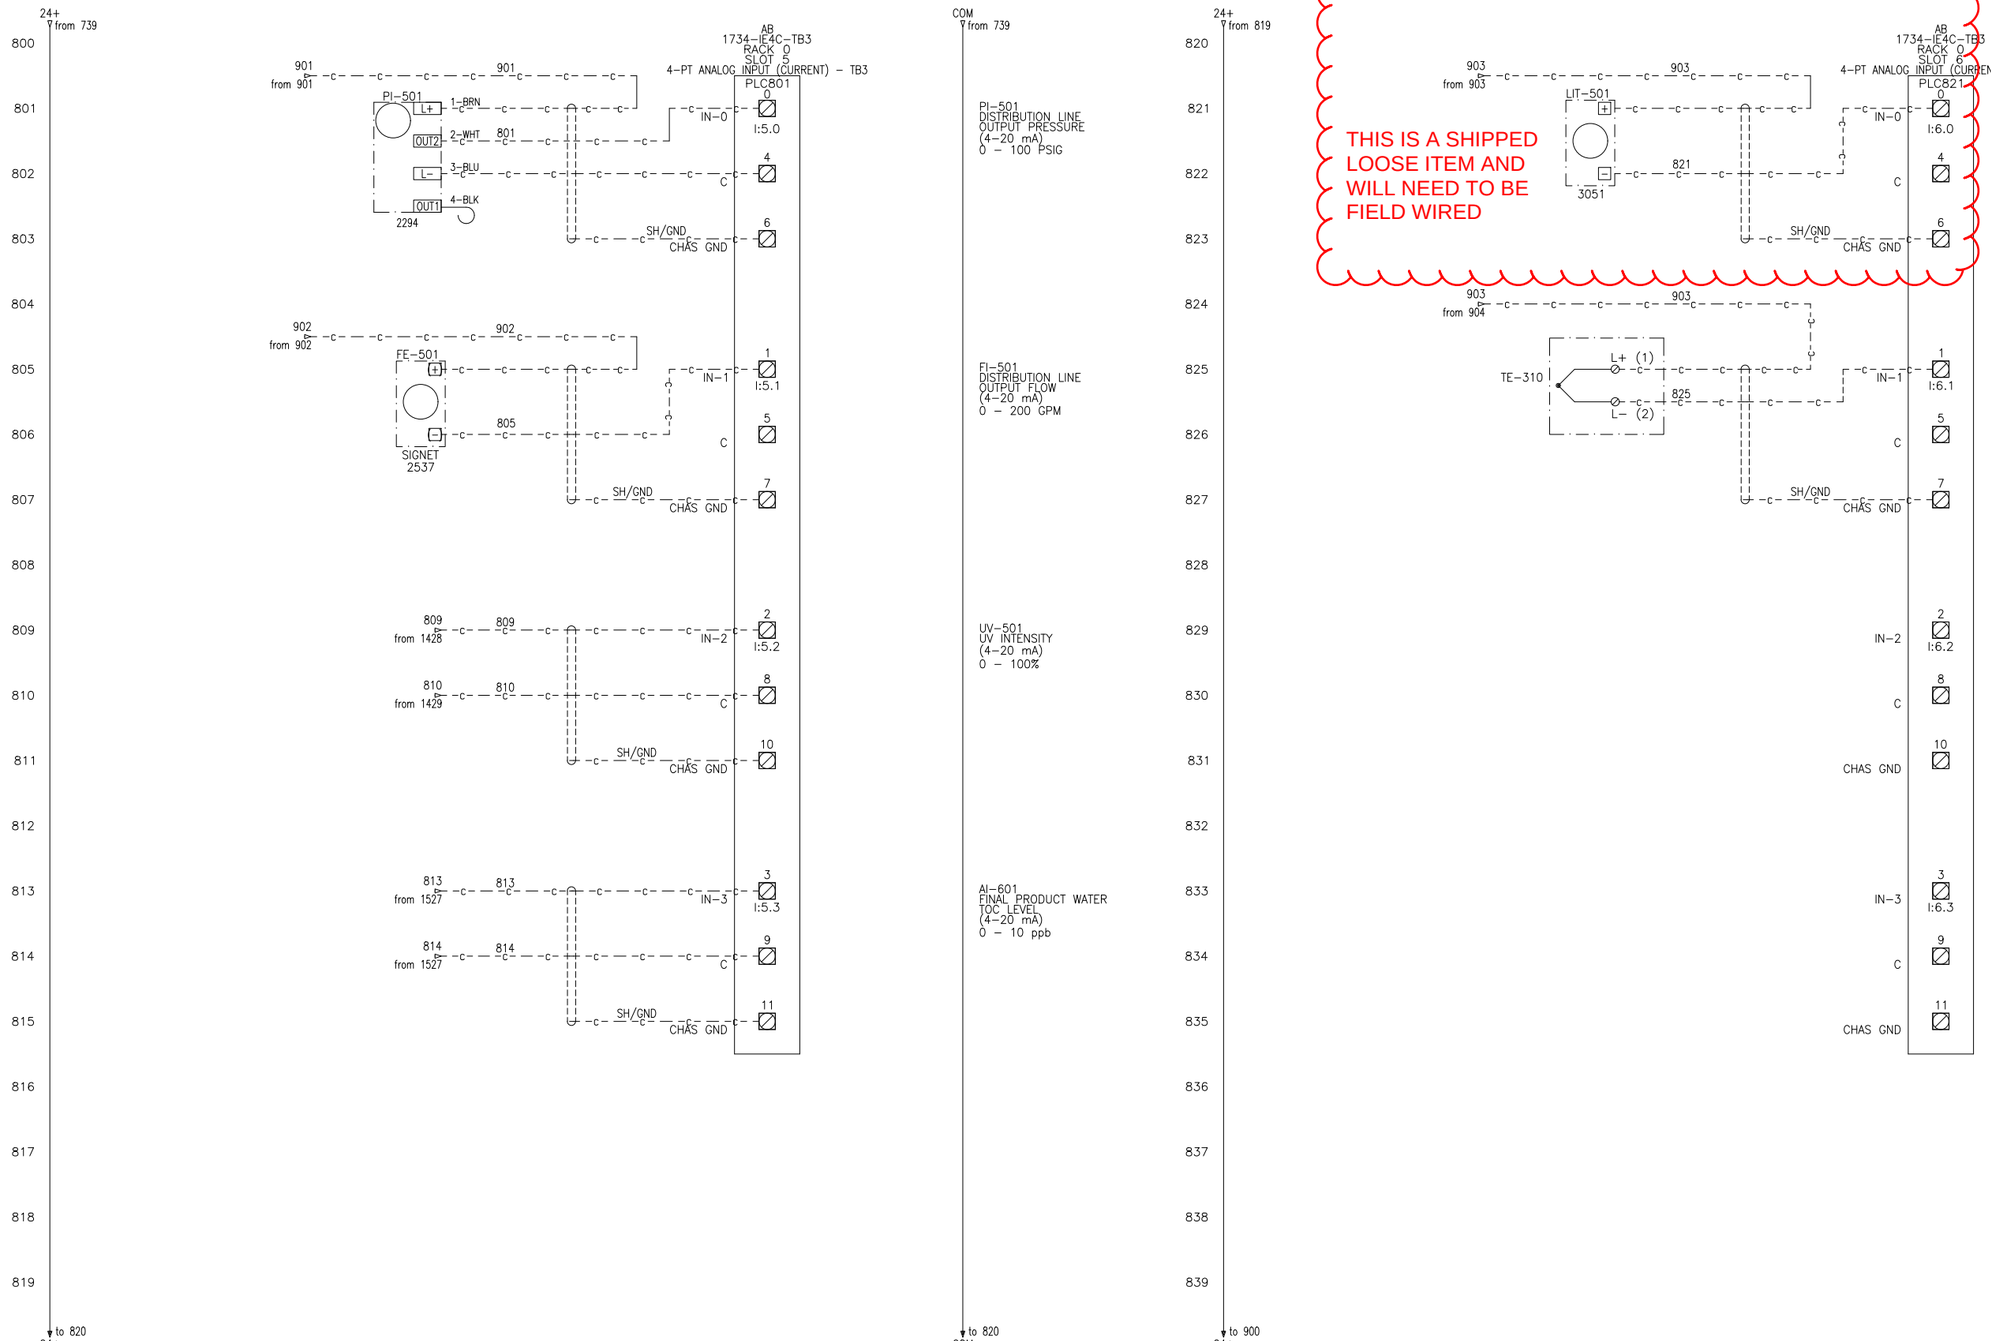

STD: Electrical v4.3

BAR = 1" AT PLOT SCALE

REV	DESCRIPTION	DATE	DWN	CKD	APPD	ECN
2	REVISE SCHEMATIC NOTE #3	2024-05-14	C.HANER	K.KALUNG	K.KALUNG	ECM127665
1	ISSUED FOR CONSTRUCTION	2024-03-26	M.KALIRA	K.KISITU	K.KISITU	-
0	ISSUED FOR CONSTRUCTION	2023-12-28	M.KALIRA	S.THANGA	K.KISITU	N/A

COMPANY CONFIDENTIAL INFORMATION
THIS DOCUMENT AND ALL INFORMATION CONTAINED HEREIN, INCLUDING THE DESIGN CONCEPTS AND THOSE ARISING THEREFROM, ARE THE PROPERTY OF EVOQUA AND/OR ITS AFFILIATES AND ARE SUBMITTED IN CONFIDENCE. THEY MAY BE USED ONLY FOR THE EXPRESS PURPOSE FOR WHICH THEY ARE PROVIDED AND MUST NOT BE DISCLOSED, REPRODUCED, OR COPIED IN ANY FORM, INCLUDING IN ELECTRONIC FORMAT, LOANED OR USED IN ANY OTHER MANNER WITHOUT THE EXPRESS WRITTEN CONSENT OF EVOQUA. ALL PATENT RIGHTS ARE RESERVED. THIS DOCUMENT AND DERIVATIVE WORKS THEREOF ARE PROTECTED UNDER APPLICABLE COPYRIGHT LAWS. UPON DEMAND OF EVOQUA, THIS DOCUMENT, ALONG WITH ALL COPIES AND EXTRACTS, AND ALL RELATED NOTES AND ANALYSES MUST BE RETURNED TO EVOQUA OR DESTROYED, AS INSTRUCTED BY EVOQUA. ACCEPTANCE OF THE DELIVERY OF THIS DOCUMENT CONSTITUTES AGREEMENT TO THESE TERMS.

DWN BY: M.KALIRA	DATE 2023-12-11	
CKD BY: S.THANGA	DATE 2023-12-11	
APPD BY: K.KISITU	DATE 2023-12-11	
MGD BY: P.RYAN	SCALE NTS	
PART NUMBER W3T602505		

TITLE: ELECTRICAL SCHEMATICS & ENCLOSURE DIAGRAMS (cETLus)
CONTAINERIZED 2-PASS RO WITH PRETREATMENT
RIO PANEL

CLIENT: ELECTRIC HYDROGEN
BEAUMONT, TX

EVOQUA WATER TECHNOLOGIES
COLORADO SPRINGS CO USA
+1 719-570-9600

PROJ/PROD NUMBER	CODE	FILE/DRAWING NUMBER	SHEET	REV
2034/001845	EC-DOS03	V112057484-08	8 OF 20	2

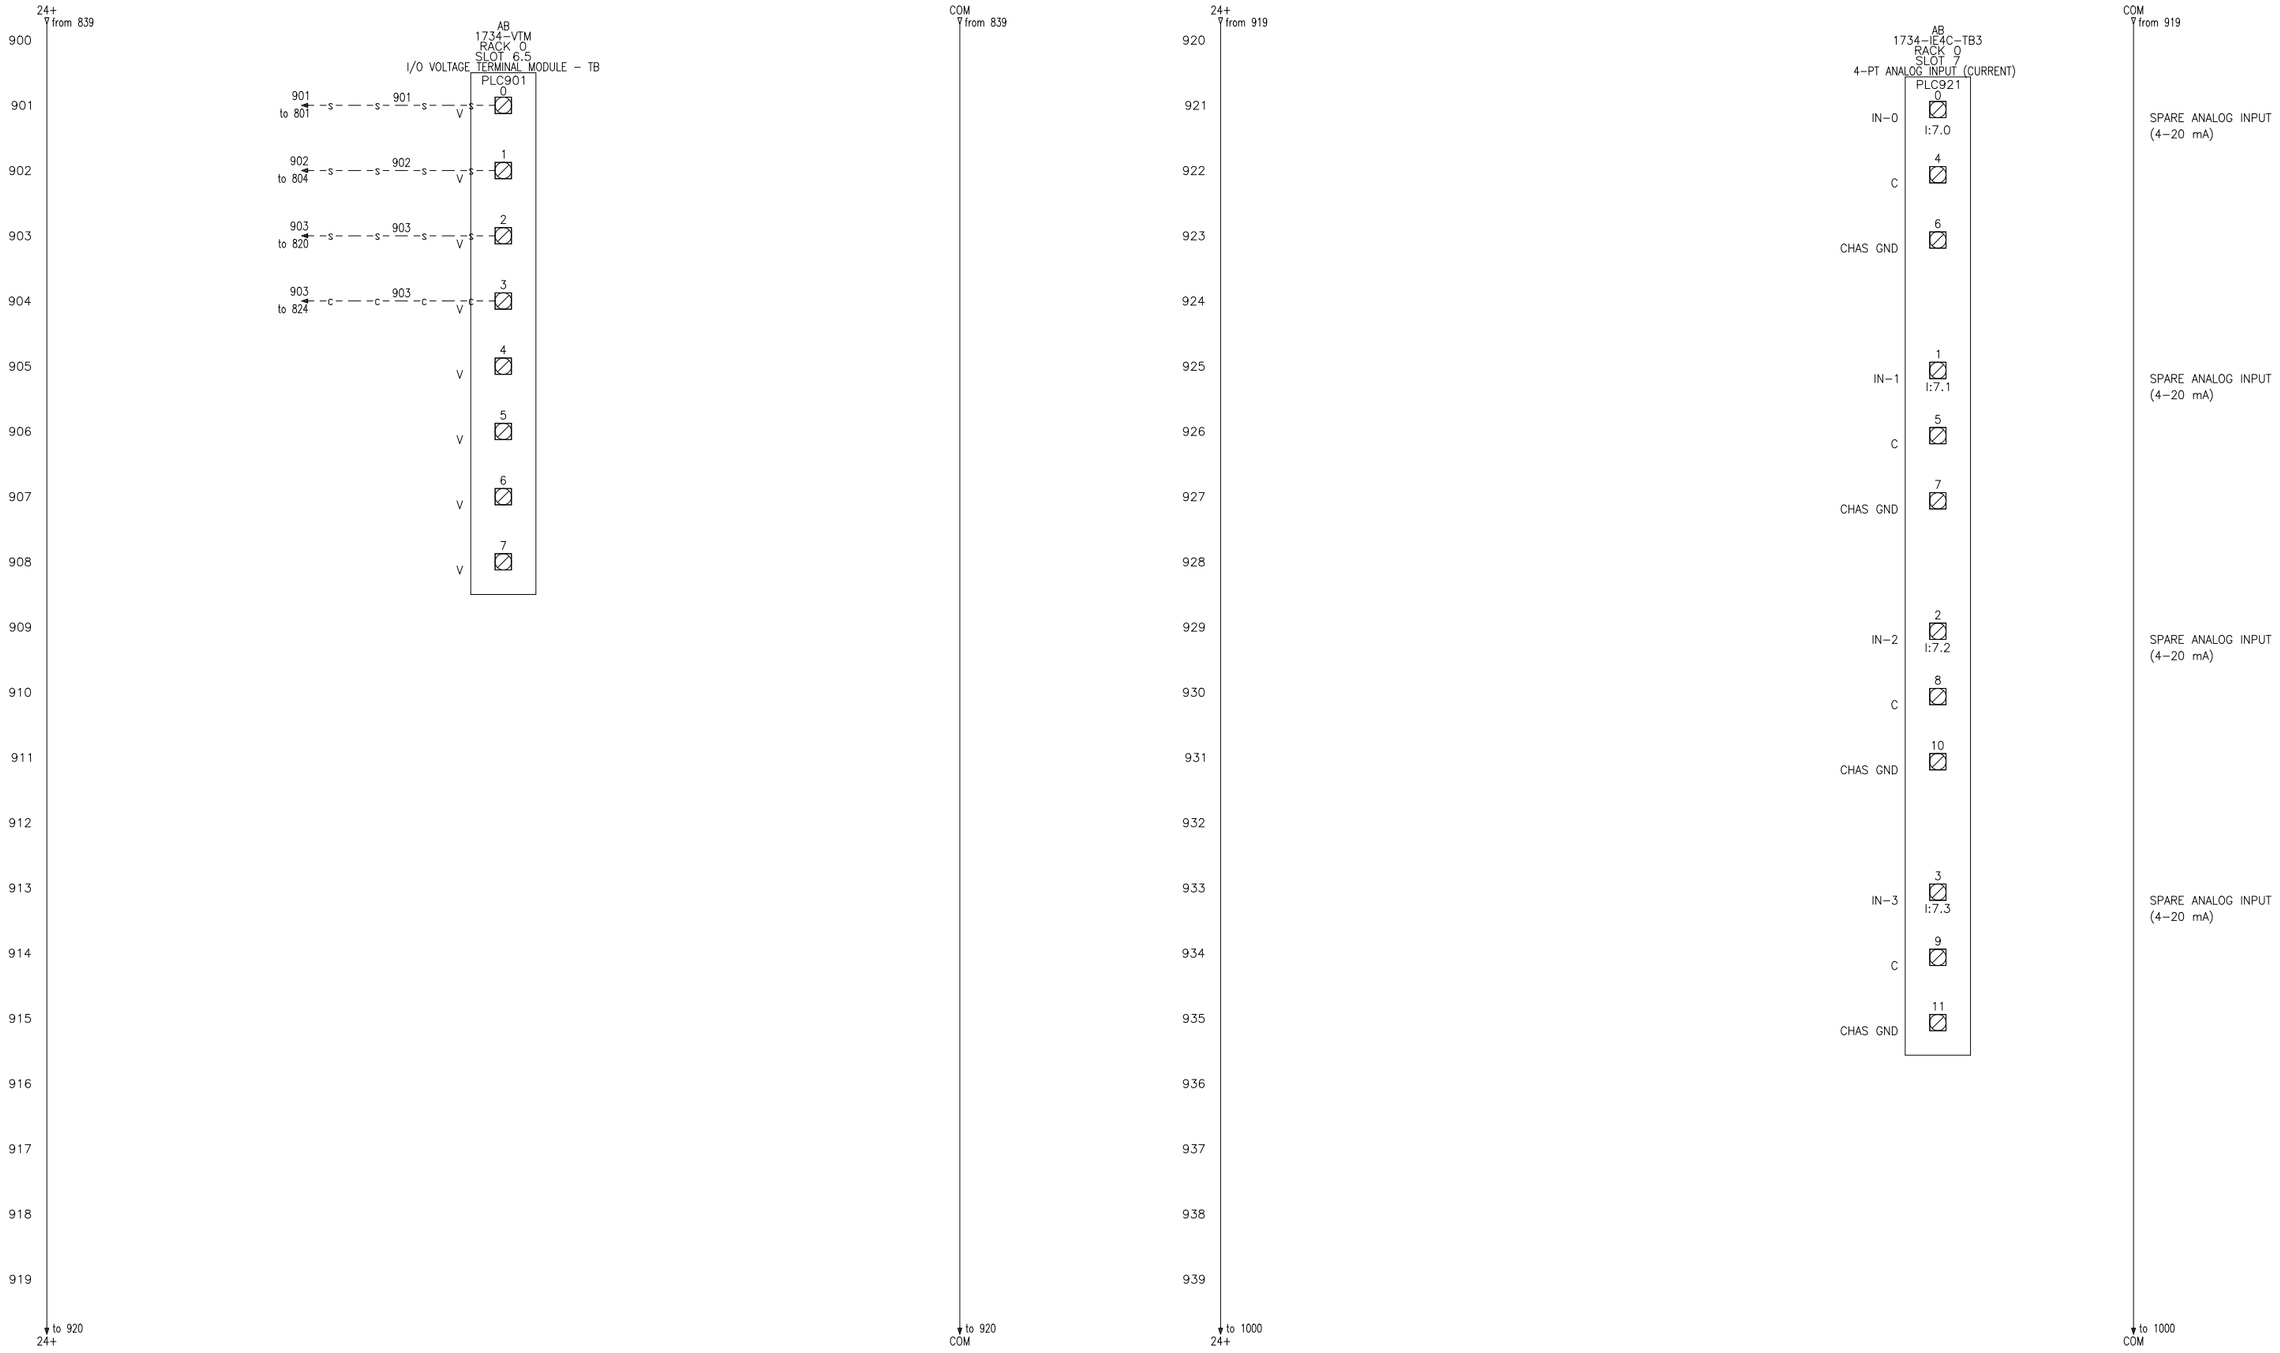

STD: Electrical v4.3

BAR = 1" AT PLOT SCALE

REV	DESCRIPTION	DATE	DWN	CKD	APPD	ECN
2	REVISE SCHEMATIC NOTE #3	2024-05-14	C.HANER	K.KALUNG	K.KALUNG	ECM127665
1	ISSUED FOR CONSTRUCTION	2024-03-26	M.KALIRA	K.KISITU	K.KISITU	-
0	ISSUED FOR CONSTRUCTION	2023-12-28	M.KALIRA	S.THANGA	K.KISITU	N/A

COMPANY CONFIDENTIAL INFORMATION
THIS DOCUMENT AND ALL INFORMATION CONTAINED HEREIN, INCLUDING THE CONCEPTS AND THOSE ARISING FROM IT, ARE THE PROPRIETARY TO EVOQUA AND/OR ITS AFFILIATES AND ARE SUBMITTED IN CONFIDENCE. THEY MAY BE USED ONLY FOR THE EXPRESS PURPOSE FOR WHICH THEY ARE PROVIDED AND MUST NOT BE DISCLOSED, REPRODUCED, OR COPIED IN ANY FORM, INCLUDING IN ELECTRONIC FORMAT, LOANED OR USED IN ANY OTHER MANNER WITHOUT THE EXPRESS WRITTEN CONSENT OF EVOQUA. ALL PATENT RIGHTS ARE RESERVED. THIS DOCUMENT AND DERIVATIVE WORKS THEREOF ARE PROTECTED UNDER APPLICABLE COPYRIGHT LAWS. UPON DEMAND OF EVOQUA, THIS DOCUMENT, ALONG WITH ALL COPIES AND EXTRACTS, AND ALL RELATED NOTES AND ANALYSES MUST BE RETURNED TO EVOQUA OR DESTROYED, AS INSTRUCTED BY EVOQUA. ACCEPTANCE OF THE DELIVERY OF THIS DOCUMENT CONSTITUTES AGREEMENT TO THESE TERMS.

DWN BY: M.KALIRA	DATE 2023-12-11	
CKD BY: S.THANGA	DATE 2023-12-11	
APPD BY: K.KISITU	DATE 2023-12-11	
MGD BY: P.RYAN	SCALE NTS	
PART NUMBER W3T602505		

TITLE: ELECTRICAL SCHEMATICS & ENCLOSURE DIAGRAMS (cETLus)
CONTAINERIZED 2-PASS RO WITH PRETREATMENT
RIO PANEL

CLIENT: ELECTRIC HYDROGEN
BEAUMONT, TX

EVOQUA WATER TECHNOLOGIES
COLORADO SPRINGS CO USA
+1 719-570-9600

PROJ/PROD NUMBER	CODE	FILE/DRAWING NUMBER	SHEET	REV
2034/001845	EC-DOS03	V112057484-09	9 OF 20	2

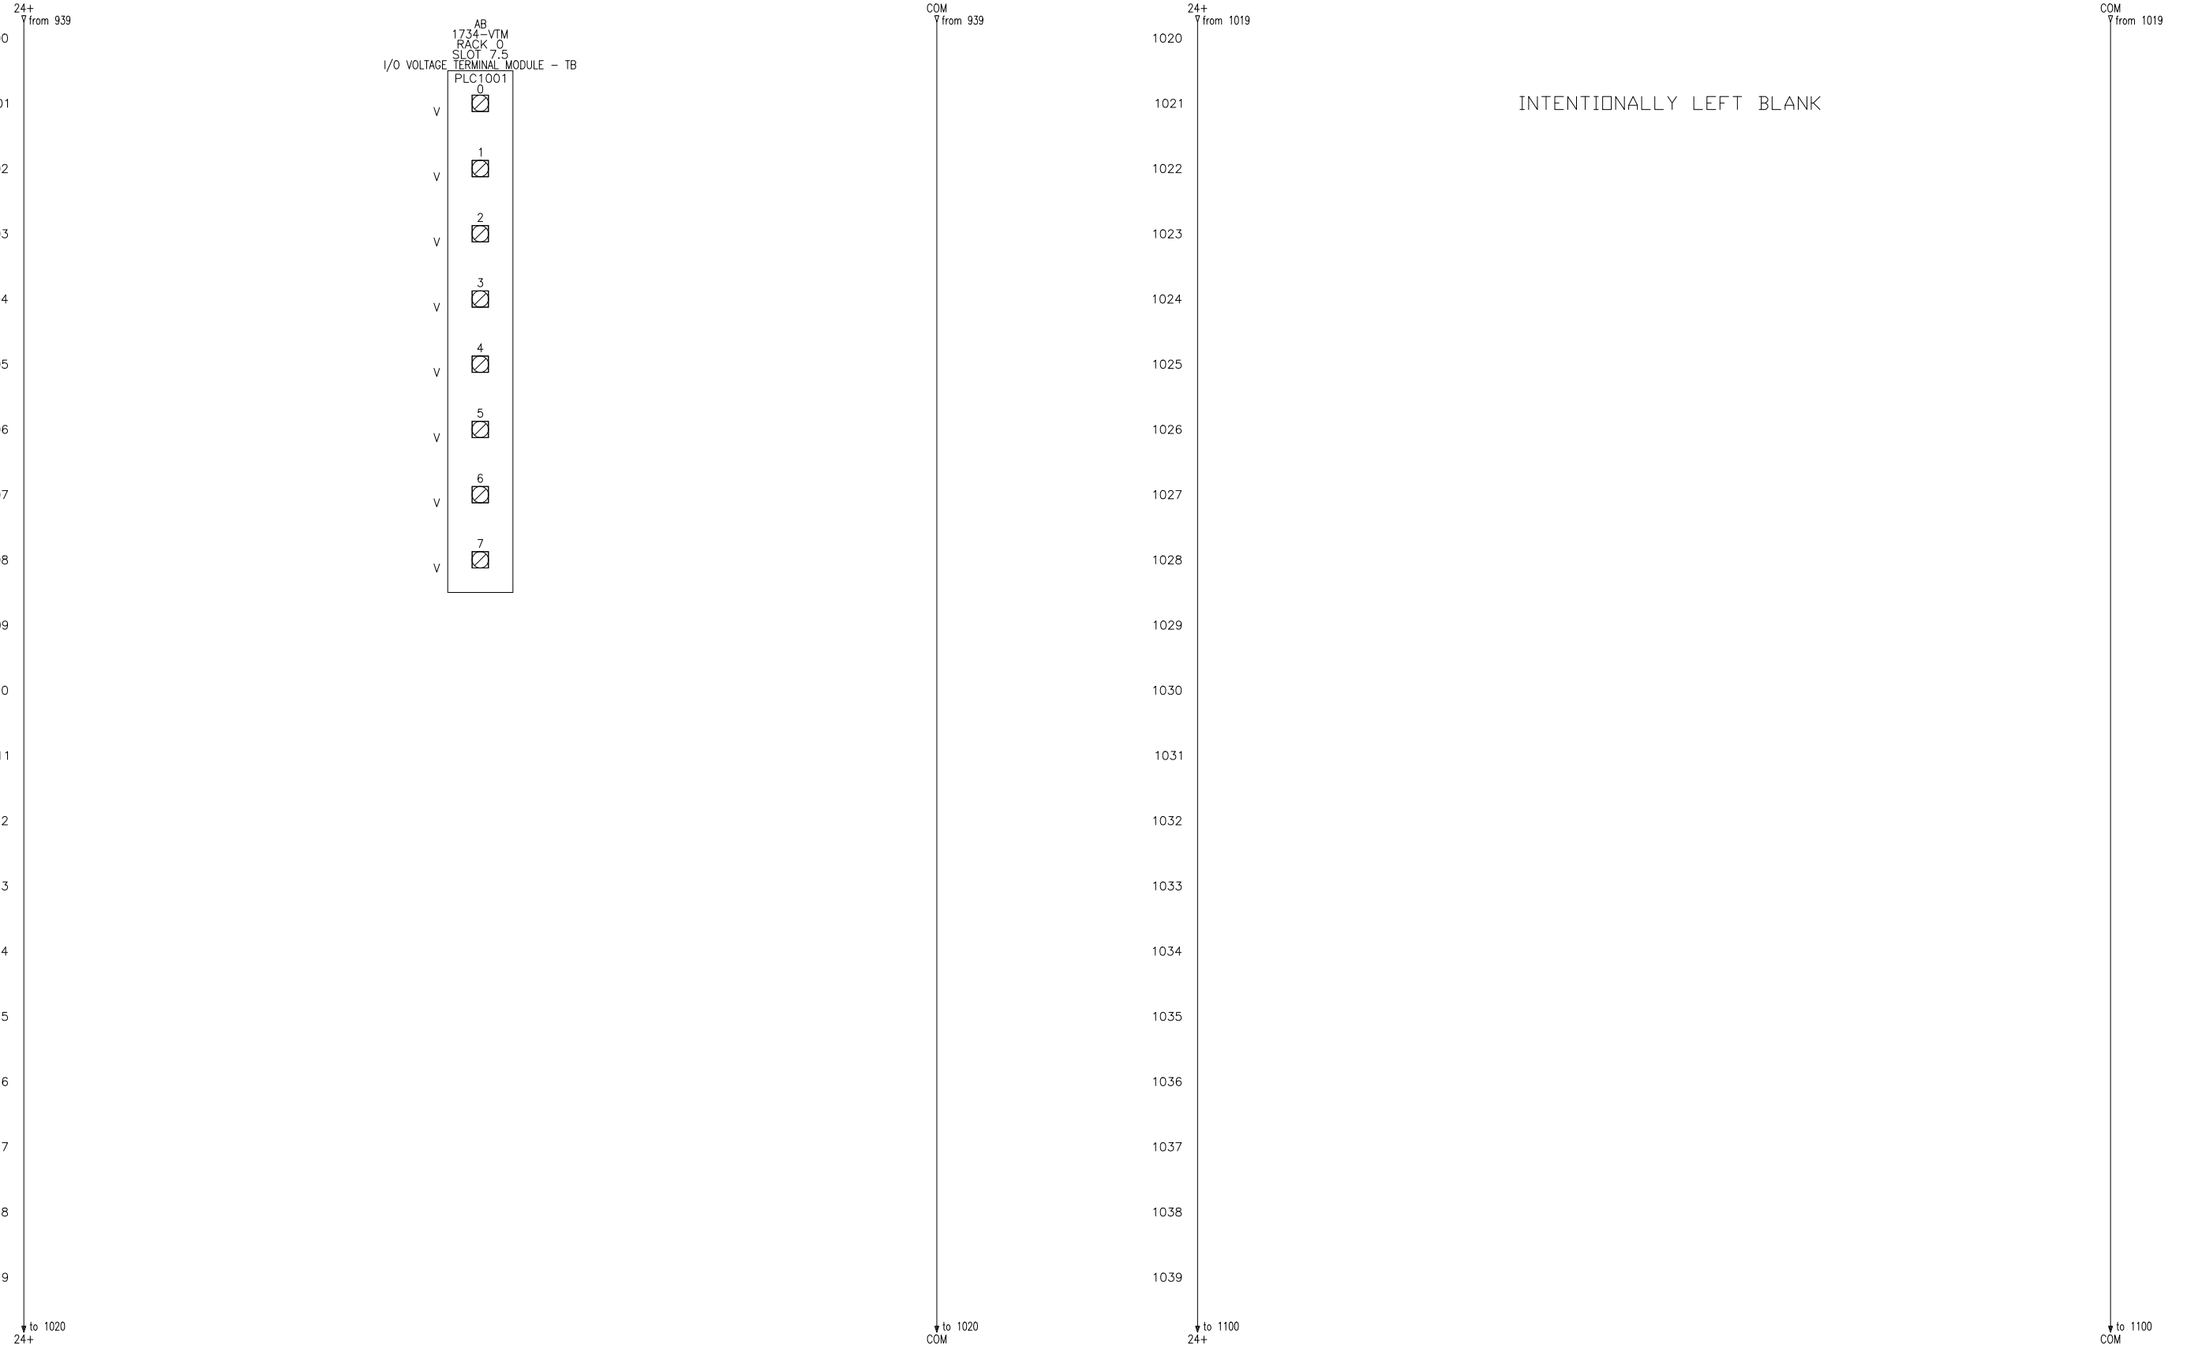

STD: Electrical v4.3

BAR = 1" AT PLOT SCALE

REV	DESCRIPTION	DATE	DWN	CKD	APPD	ECN
2	REVISE SCHEMATIC NOTE #3	2024-05-14	C.HANER	K.KALUNG	K.KALUNG	ECM127665
1	ISSUED FOR CONSTRUCTION	2024-03-26	M.KALIRA	K.KISITU	K.KISITU	-
0	ISSUED FOR CONSTRUCTION	2023-12-28	M.KALIRA	S.THANGA	K.KISITU	N/A

COMPANY CONFIDENTIAL INFORMATION
THIS DOCUMENT AND ALL INFORMATION CONTAINED HEREIN, INCLUDING THE DESIGN CONCEPTS AND THOSE ARISING THEREFROM, ARE THE PROPERTY OF EVOQUA AND/OR ITS AFFILIATES AND ARE SUBMITTED IN CONFIDENCE. THEY MAY BE USED ONLY FOR THE EXPRESS PURPOSE FOR WHICH THEY ARE PROVIDED AND MUST NOT BE DISCLOSED, REPRODUCED, OR COPIED IN ANY FORM, INCLUDING IN ELECTRONIC FORMAT, LOANED OR USED IN ANY OTHER MANNER WITHOUT THE PRIOR WRITTEN CONSENT OF EVOQUA. ALL PATENT RIGHTS ARE RESERVED. THIS DOCUMENT AND DERIVATIVE WORKS THEREOF ARE PROTECTED UNDER APPLICABLE COPYRIGHT LAWS. UPON DEMAND OF EVOQUA, THIS DOCUMENT, ALONG WITH ALL COPIES AND EXTRACTS, AND ALL RELATED NOTES AND ANALYSES MUST BE RETURNED TO EVOQUA OR DESTROYED, AS INSTRUCTED BY EVOQUA. ACCEPTANCE OF THE DELIVERY OF THIS DOCUMENT CONSTITUTES AGREEMENT TO THESE TERMS.

DWN BY: M.KALIRA	DATE 2023-12-11	
CKD BY: S.THANGA	DATE 2023-12-11	
APPD BY: K.KISITU	DATE 2023-12-11	
MGD BY: P.RYAN	SCALE NTS	
PART NUMBER W3T602505		

TITLE: ELECTRICAL SCHEMATICS & ENCLOSURE DIAGRAMS (cETLus)
CONTAINERIZED 2-PASS RO WITH PRETREATMENT
RIO PANEL

CLIENT: ELECTRIC HYDROGEN
BEAUMONT, TX

EVOQUA WATER TECHNOLOGIES
COLORADO SPRINGS CO USA
+1 719-570-9600

PROJ/PROD NUMBER	CODE	FILE/DRAWING NUMBER	SHEET	REV
2034/001845	EC-DOS03	V112057484-10	10 OF 20	2

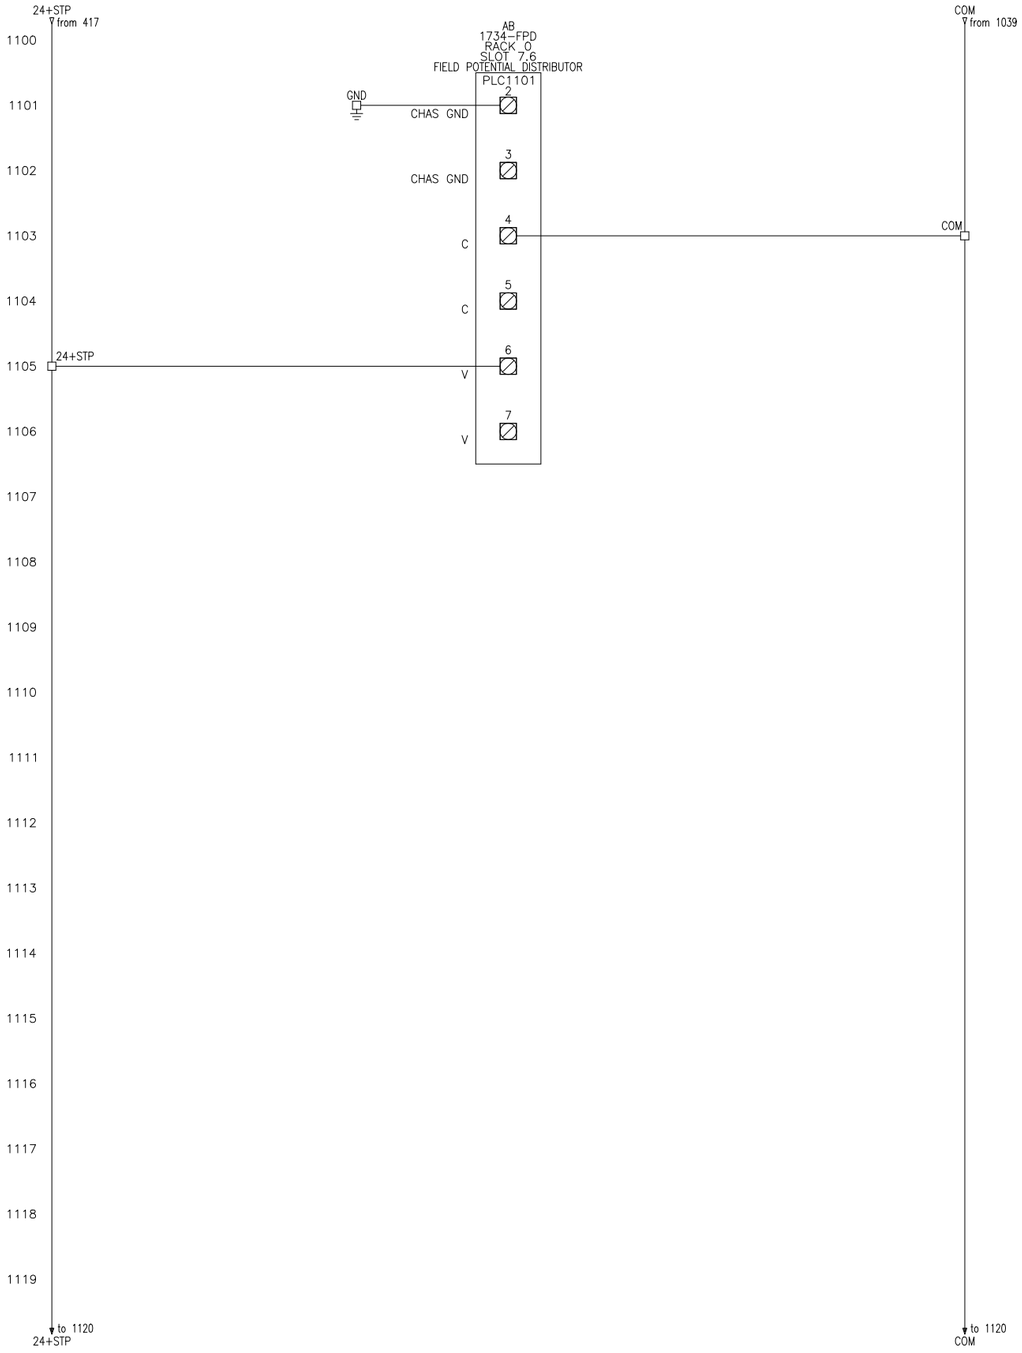

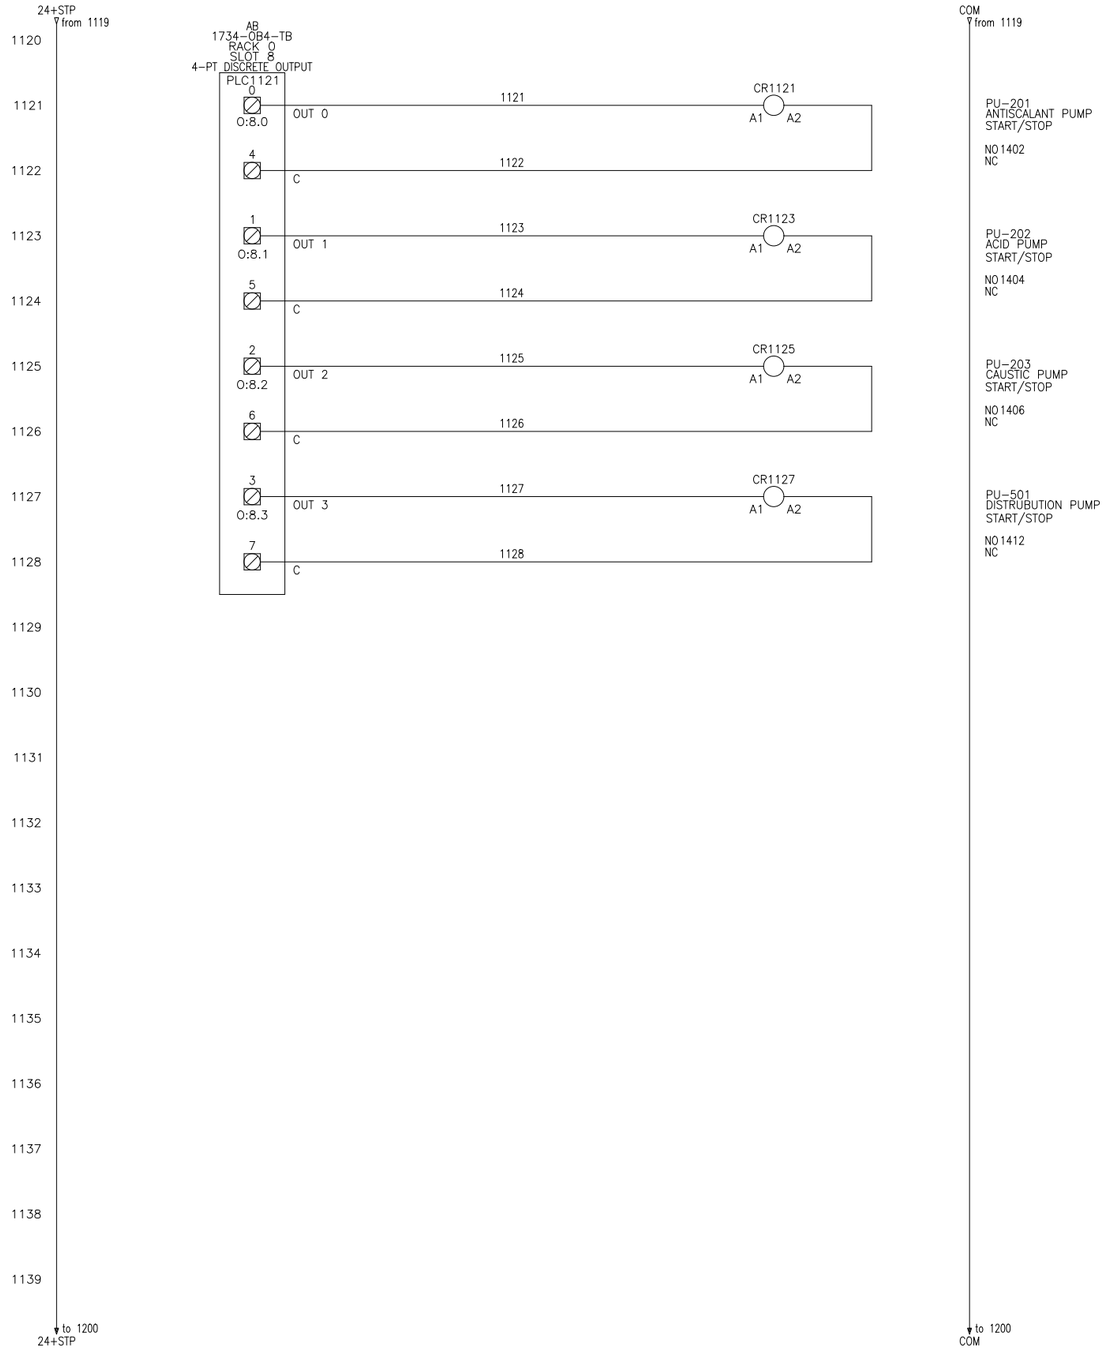

BAR = 1" AT PLOT SCALE

STD: Electrical v4.3

REV	DESCRIPTION	DATE	DWN	CKD	APPD	ECN
2	REVISE SCHEMATIC NOTE #3	2024-05-14	C.HANER	K.KALUNG	K.KALUNG	ECM127665
1	ISSUED FOR CONSTRUCTION	2024-03-26	M.KALIRA	K.KISITU	K.KISITU	-
0	ISSUED FOR CONSTRUCTION	2023-12-28	M.KALIRA	S.THANGA	K.KISITU	N/A

COMPANY CONFIDENTIAL INFORMATION
THIS DOCUMENT AND ALL INFORMATION CONTAINED HEREIN, INCLUDING THE DESIGN CONCEPTS AND THOSE ARISING THEREFROM, ARE THE PROPERTY OF EVOQUA AND/OR ITS AFFILIATES AND ARE SUBMITTED IN CONFIDENCE. THEY MAY BE USED ONLY FOR THE EXPRESS PURPOSE FOR WHICH THEY ARE PROVIDED AND MUST NOT BE DISCLOSED, REPRODUCED, OR COPIED IN ANY FORM, INCLUDING IN ELECTRONIC FORMAT, LOANED OR USED IN ANY OTHER MANNER WITHOUT THE PRIOR WRITTEN PERMISSION OF EVOQUA. ALL PATENT RIGHTS ARE RESERVED. THIS DOCUMENT AND DERIVATIVE WORKS THEREOF ARE PROTECTED UNDER APPLICABLE COPYRIGHT LAWS. UPON DEMAND OF EVOQUA, THIS DOCUMENT, ALONG WITH ALL COPIES AND EXTRACTS, AND ALL RELATED NOTES AND ANALYSES MUST BE RETURNED TO EVOQUA OR DESTROYED, AS INSTRUCTED BY EVOQUA. ACCEPTANCE OF THE DELIVERY OF THIS DOCUMENT CONSTITUTES AGREEMENT TO THESE TERMS.

DWN BY: M.KALIRA	DATE 2023-12-11
CKD BY: S.THANGA	DATE 2023-12-11
APPD BY: K.KISITU	DATE 2023-12-11
MGD BY: P.RYAN	SCALE NTS
PART NUMBER W3T602505	

TITLE: ELECTRICAL SCHEMATICS & ENCLOSURE DIAGRAMS (cETLus)
CONTAINERIZED 2-PASS RO WITH PRETREATMENT
RIO PANEL

CLIENT: ELECTRIC HYDROGEN
BEAUMONT, TX

EVOQUA WATER TECHNOLOGIES
COLORADO SPRINGS CO USA
+1 719-570-9600

PROJ/PROD NUMBER	CODE	FILE/DRAWING NUMBER	SHEET	REV
2034/001845	EC-DOS03	V112057484-11	11 OF 20	2

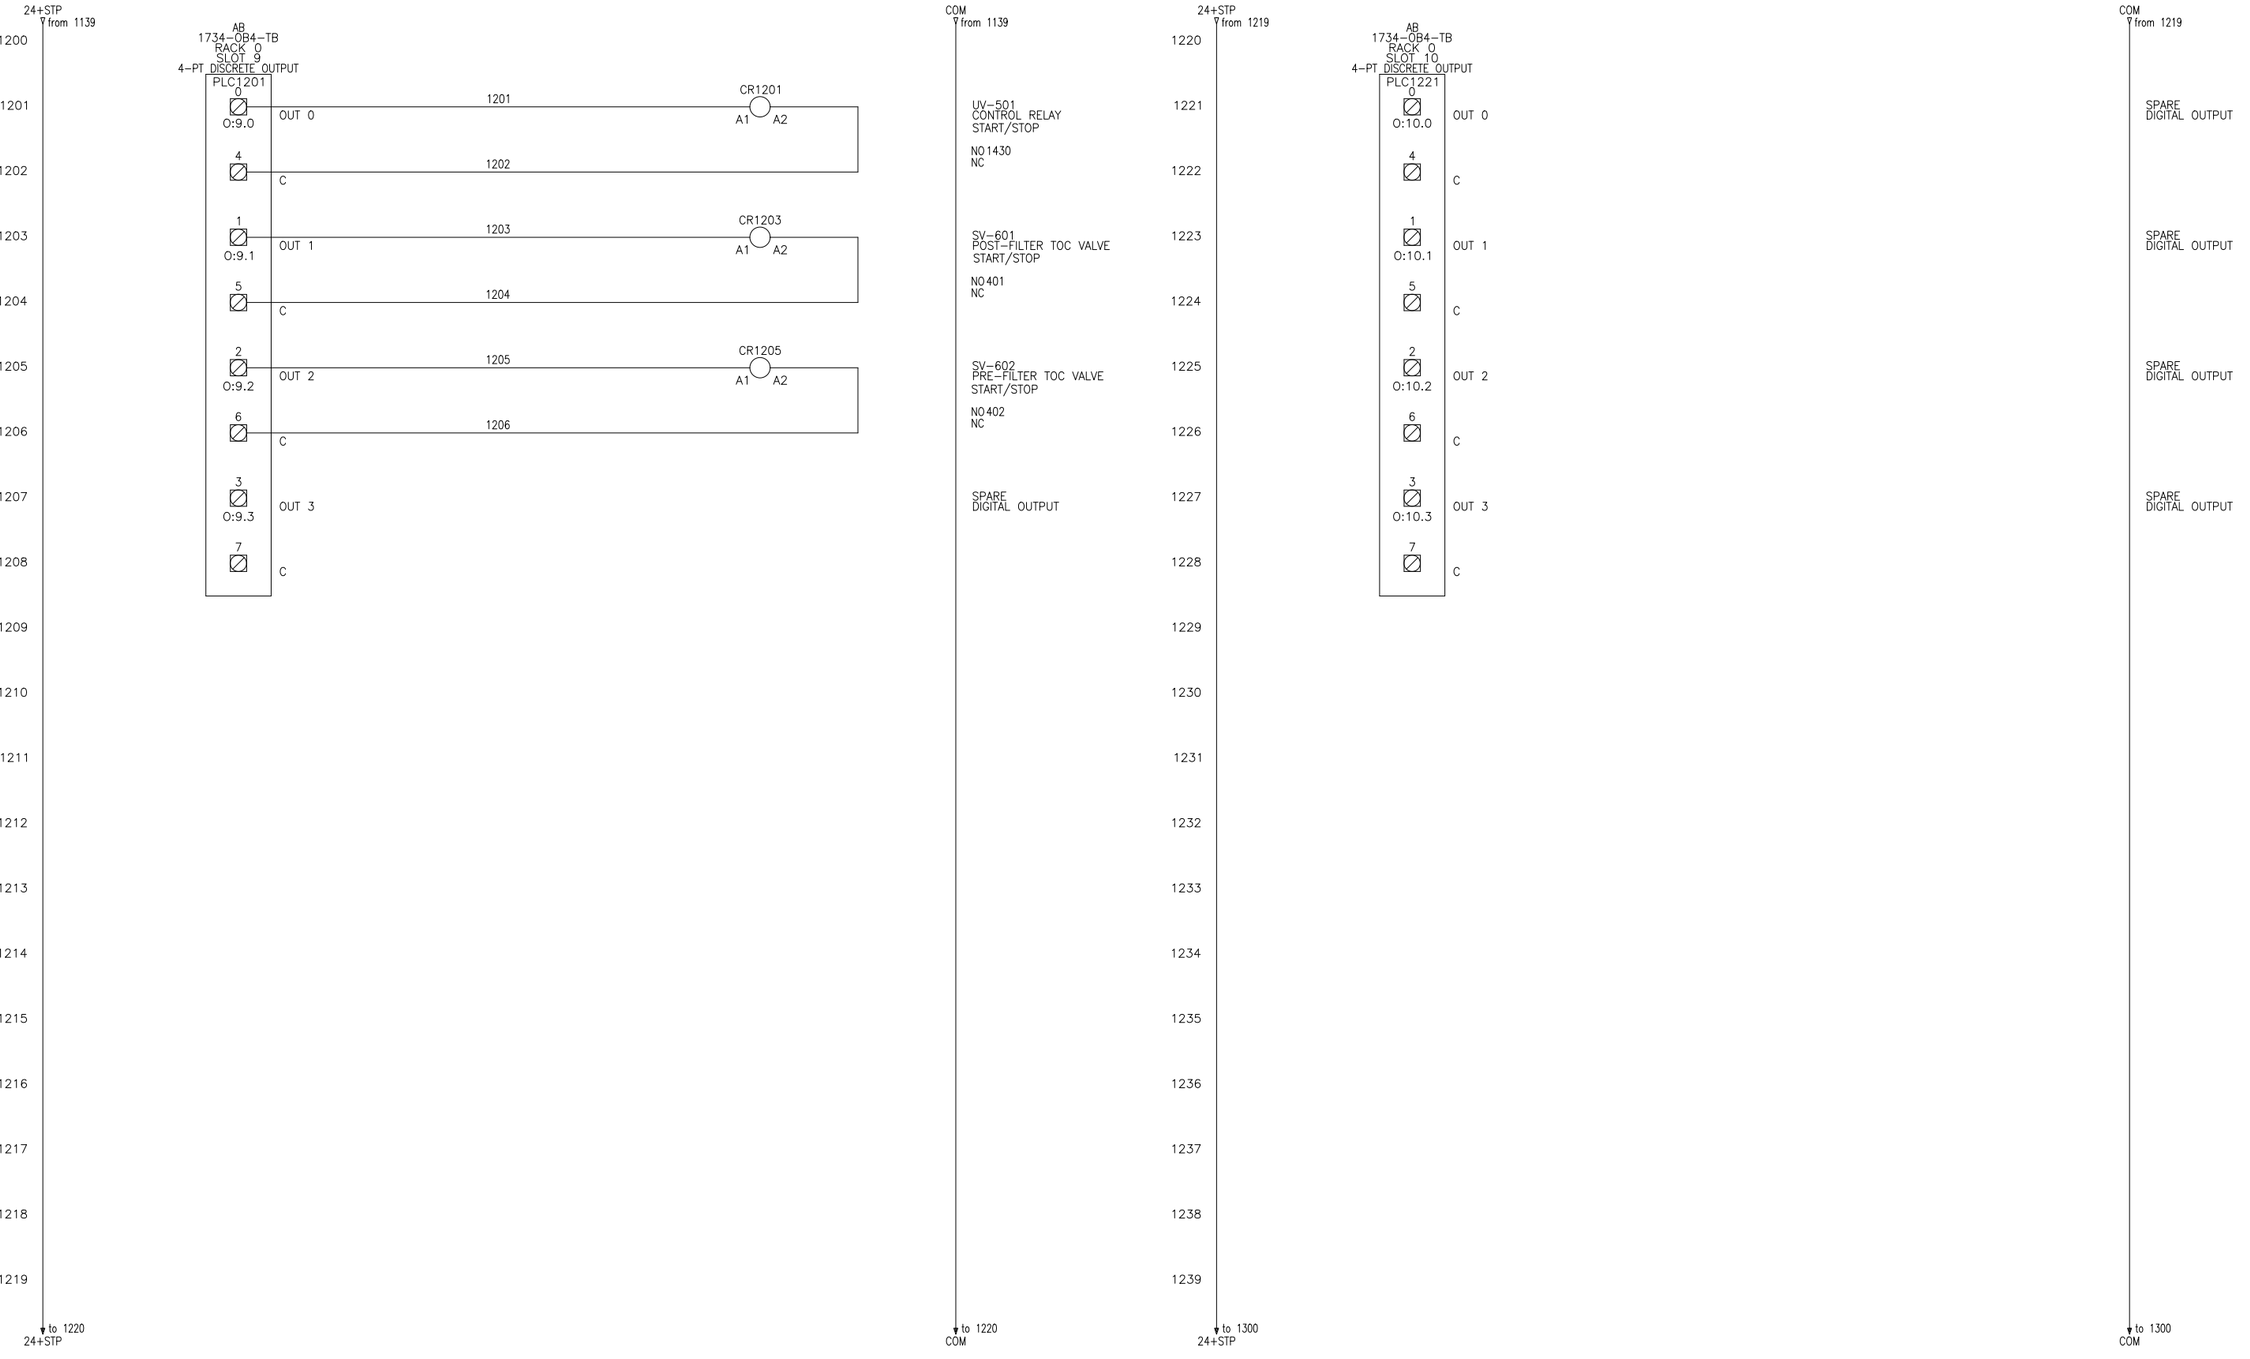

REV	DESCRIPTION	DATE	DWN	CKD	APPD	ECN
2	REVISE SCHEMATIC NOTE #3	2024-05-14	C.HANER	K.KALUNG	K.KALUNG	ECM127665
1	ISSUED FOR CONSTRUCTION	2024-03-26	M.KALIRA	K.KISITU	K.KISITU	-
0	ISSUED FOR CONSTRUCTION	2023-12-28	M.KALIRA	S.THANGA	K.KISITU	N/A

COMPANY CONFIDENTIAL INFORMATION
THIS DOCUMENT AND ALL INFORMATION CONTAINED HEREIN, INCLUDING THE DESIGN CONCEPTS AND THOSE ARISING THEREFROM, ARE THE PROPERTY OF EVOQUA AND/OR ITS AFFILIATES AND ARE SUBMITTED IN CONFIDENCE. THEY MAY BE USED ONLY FOR THE EXPRESS PURPOSE FOR WHICH THEY ARE PROVIDED AND MUST NOT BE DISCLOSED, REPRODUCED, OR COPIED IN ANY FORM, INCLUDING IN ELECTRONIC FORM, LOANED OR USED IN ANY OTHER MANNER WITHOUT THE PRIOR WRITTEN CONSENT OF EVOQUA. ALL PATENT RIGHTS ARE RESERVED. THIS DOCUMENT AND DERIVATIVE WORKS THEREOF ARE PROTECTED UNDER APPLICABLE COPYRIGHT LAWS. UPON DEMAND OF EVOQUA, THIS DOCUMENT, ALONG WITH ALL COPIES AND EXTRACTS, AND ALL RELATED NOTES AND ANALYSES MUST BE RETURNED TO EVOQUA OR DESTROYED, AS INSTRUCTED BY EVOQUA. ACCEPTANCE OF THE DELIVERY OF THIS DOCUMENT CONSTITUTES AGREEMENT TO THESE TERMS.

DWN BY: M.KALIRA	DATE 2023-12-11
CKD BY: S.THANGA	DATE 2023-12-11
APPD BY: K.KISITU	DATE 2023-12-11
MGD BY: P.RYAN	SCALE NTS
PART NUMBER W3T602505	

TITLE: ELECTRICAL SCHEMATICS & ENCLOSURE DIAGRAMS (cETLus)
CONTAINERIZED 2-PASS RO WITH PRETREATMENT
RIO PANEL

CLIENT: ELECTRIC HYDROGEN
BEAUMONT, TX

EVOQUA WATER TECHNOLOGIES
COLORADO SPRINGS CO USA
+1 719-570-9600

PROJ/PROD NUMBER	CODE	FILE/DRAWING NUMBER	SHEET	REV
2034/001845	EC-DOS03	V112057484-12	12 OF 20	2

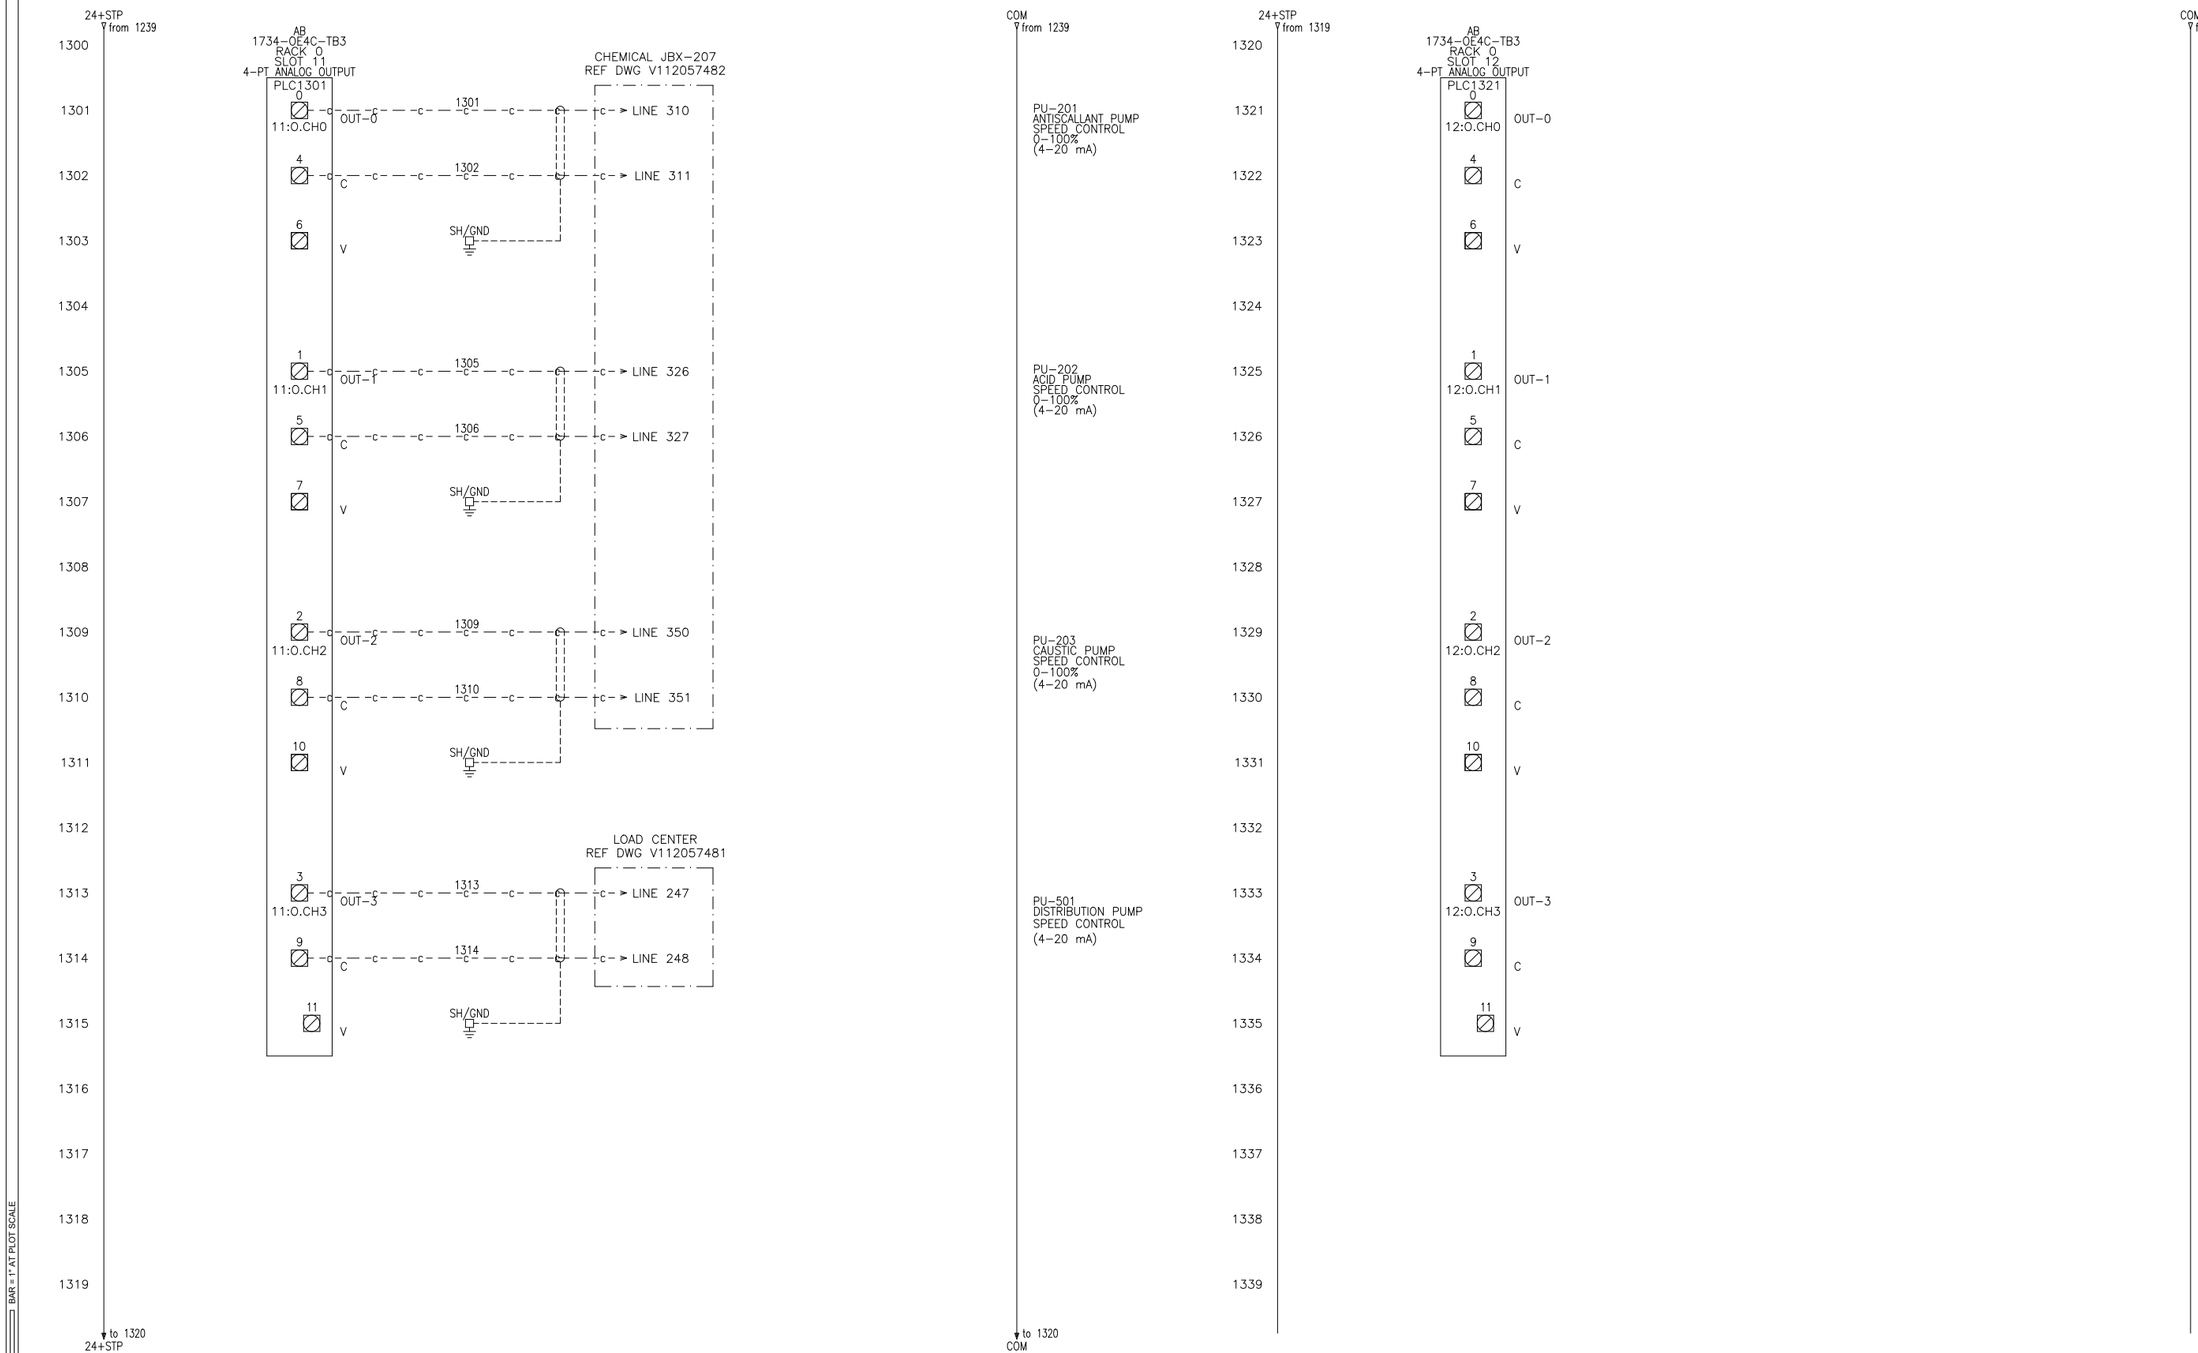

REV	DESCRIPTION	DATE	DWN	CKD	APPD	ECN
2	REVISE SCHEMATIC NOTE #3	2024-05-14	C.HANER	K.KALUNG	K.KALUNG	ECM127665
1	ISSUED FOR CONSTRUCTION	2024-03-26	M.KALIRA	K.KISITU	K.KISITU	-
0	ISSUED FOR CONSTRUCTION	2023-12-28	M.KALIRA	S.THANGA	K.KISITU	N/A

COMPANY CONFIDENTIAL INFORMATION
THIS DOCUMENT AND ALL INFORMATION CONTAINED HEREIN, INCLUDING THE DESIGN CONCEPTS AND THOSE ARISING THEREFROM, ARE THE PROPERTY OF EVOQUA AND/OR ITS AFFILIATES AND ARE SUBMITTED IN CONFIDENCE. THEY MAY BE USED ONLY FOR THE EXPRESS PURPOSE FOR WHICH THEY ARE PROVIDED AND MUST NOT BE DISCLOSED, REPRODUCED, OR COPIED IN ANY FORM, INCLUDING IN ELECTRONIC FORMAT, LOANED OR USED IN ANY OTHER MANNER WITHOUT THE EXPRESS WRITTEN CONSENT OF EVOQUA. ALL PATENT RIGHTS ARE RESERVED. THIS DOCUMENT AND DERIVATIVE WORKS THEREOF ARE PROTECTED UNDER APPLICABLE COPYRIGHT LAWS. UPON DEMAND OF EVOQUA, THIS DOCUMENT, ALONG WITH ALL COPIES AND EXTRACTS, AND ALL RELATED NOTES AND ANALYSES MUST BE RETURNED TO EVOQUA OR DESTROYED, AS INSTRUCTED BY EVOQUA. ACCEPTANCE OF THE DELIVERY OF THIS DOCUMENT CONSTITUTES AGREEMENT TO THESE TERMS.

DWN BY: M.KALIRA	DATE 2023-12-11	
CKD BY: S.THANGA	DATE 2023-12-11	
APPD BY: K.KISITU	DATE 2023-12-11	
MGD BY: P.RYAN	SCALE NTS	
PART NUMBER W3T602505		

TITLE: ELECTRICAL SCHEMATICS & ENCLOSURE DIAGRAMS (cETLus)
CONTAINERIZED 2-PASS RO WITH PRETREATMENT
RIO PANEL

CLIENT: ELECTRIC HYDROGEN
BEAUMONT, TX

EVOQUA WATER TECHNOLOGIES
COLORADO SPRINGS CO USA
+1 719-570-9600

PROJ/PROD NUMBER	CODE	FILE/DRAWING NUMBER	SHEET	REV
2034/001845	EC-DOS03	V112057484-13	13 OF 20	2

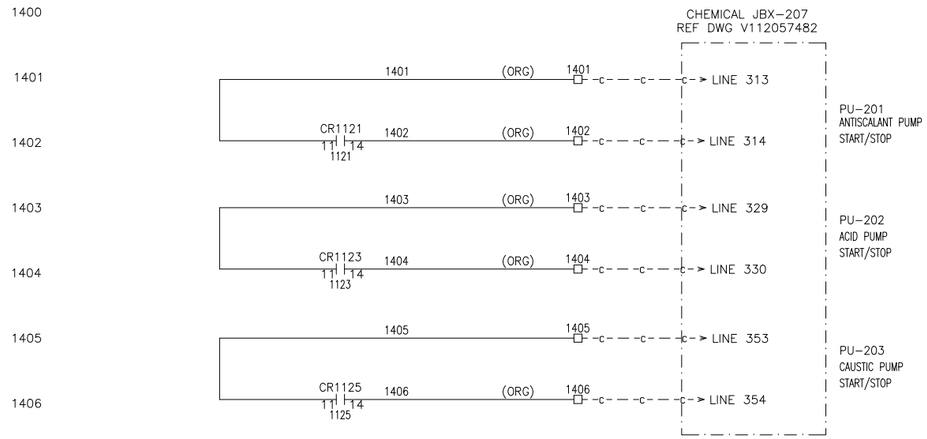

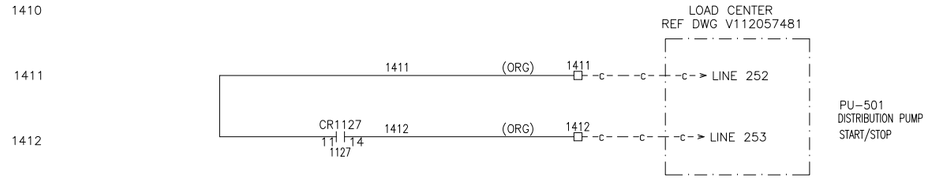

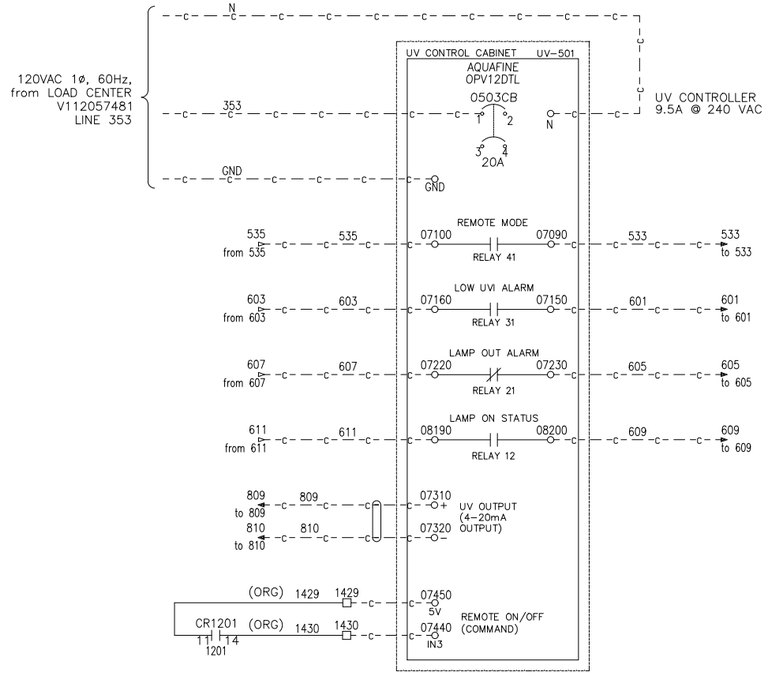

STD: Electrical v4.3

BAR = 1" AT PLOT SCALE

REV	DESCRIPTION	DATE	DWN	CKD	APPD	ECN
2	REVISE SCHEMATIC NOTE #3	2024-05-14	C.HANER	K.KALUNG	K.KALUNG	ECM127665
1	ISSUED FOR CONSTRUCTION	2024-03-26	M.KALIRA	K.KISITU	K.KISITU	-
0	ISSUED FOR CONSTRUCTION	2023-12-28	M.KALIRA	S.THANGA	K.KISITU	N/A

COMPANY CONFIDENTIAL INFORMATION
THIS DOCUMENT AND ALL INFORMATION CONTAINED HEREIN, INCLUDING THE DESIGN CONCEPTS AND THOSE ARISING THEREFROM, ARE THE PROPERTY OF EVOQUA AND/OR ITS AFFILIATES AND ARE SUBMITTED IN CONFIDENCE. THEY MAY BE USED ONLY FOR THE EXPRESS PURPOSE FOR WHICH THEY ARE PROVIDED AND MUST NOT BE DISCLOSED, REPRODUCED, OR COPIED IN ANY FORM, INCLUDING IN ELECTRONIC FORMAT, LOANED OR USED IN ANY OTHER MANNER WITHOUT THE EXPRESS WRITTEN CONSENT OF EVOQUA. ALL PATENT RIGHTS ARE RESERVED. THIS DOCUMENT AND DERIVATIVE WORKS THEREOF ARE PROTECTED UNDER APPLICABLE COPYRIGHT LAWS. UPON DEMAND OF EVOQUA, THIS DOCUMENT, ALONG WITH ALL COPIES AND EXTRACTS, AND ALL RELATED NOTES AND ANALYSES MUST BE RETURNED TO EVOQUA OR DESTROYED, AS INSTRUCTED BY EVOQUA. ACCEPTANCE OF THE DELIVERY OF THIS DOCUMENT CONSTITUTES AGREEMENT TO THESE TERMS.

DWN BY: M.KALIRA	DATE 2023-12-11	
CKD BY: S.THANGA	DATE 2023-12-11	
APPD BY: K.KISITU	DATE 2023-12-11	
MGD BY: P.RYAN	SCALE NTS	
PART NUMBER W3T602505		

TITLE: ELECTRICAL SCHEMATICS & ENCLOSURE DIAGRAMS (cETLus)
CONTAINERIZED 2-PASS RO WITH PRETREATMENT
RIO PANEL

CLIENT: ELECTRIC HYDROGEN
BEAUMONT, TX

EVOQUA WATER TECHNOLOGIES
COLORADO SPRINGS CO USA
+1 719-570-9600

PROJ/PROD NUMBER	CODE	FILE/DRAWING NUMBER	SHEET	REV
2034/001845	EC-DOS03	V112057484-14	14 OF 20	2

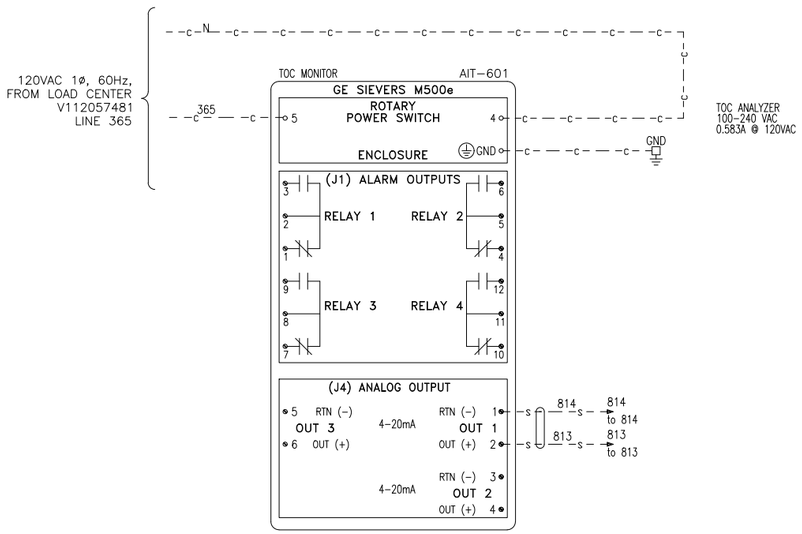

REV	DESCRIPTION	DATE	DWN	CKD	APPD	ECN
2	REVISE SCHEMATIC NOTE #3	2024-05-14	C.HANER	K.KALUNG	K.KALUNG	ECM127665
1	ISSUED FOR CONSTRUCTION	2024-03-26	M.KALIRA	K.KISITU	K.KISITU	-
0	ISSUED FOR CONSTRUCTION	2023-12-28	M.KALIRA	S.THANGA	K.KISITU	N/A

COMPANY CONFIDENTIAL INFORMATION
THIS DOCUMENT AND ALL INFORMATION CONTAINED HEREIN, INCLUDING THE DESIGN CONCEPTS AND THOSE ARISING THEREFROM, ARE THE PROPERTY OF EVOQUA AND/OR ITS AFFILIATES AND ARE SUBMITTED IN CONFIDENCE. THEY MAY BE USED ONLY FOR THE EXPRESS PURPOSE FOR WHICH THEY ARE PROVIDED AND MUST NOT BE DISCLOSED, REPRODUCED, OR COPIED IN ANY FORM, INCLUDING IN ELECTRONIC FORMAT, LOANED OR USED IN ANY OTHER MANNER WITHOUT THE PRIOR WRITTEN CONSENT OF EVOQUA. ALL PATENT RIGHTS ARE RESERVED. THIS DOCUMENT AND DERIVATIVE WORKS THEREOF ARE PROTECTED UNDER APPLICABLE COPYRIGHT LAWS. UPON DEMAND OF EVOQUA, THIS DOCUMENT, ALONG WITH ALL COPIES AND EXTRACTS, AND ALL RELATED NOTES AND ANALYSES MUST BE RETURNED TO EVOQUA OR DESTROYED, AS INSTRUCTED BY EVOQUA. ACCEPTANCE OF THE DELIVERY OF THIS DOCUMENT CONSTITUTES AGREEMENT TO THESE TERMS.

DWN BY: M.KALIRA	DATE 2023-12-11
CKD BY: S.THANGA	DATE 2023-12-11
APPD BY: K.KISITU	DATE 2023-12-11
MGD BY: P.RYAN	SCALE NTS
PART NUMBER W3T602505	

TITLE: ELECTRICAL SCHEMATICS & ENCLOSURE DIAGRAMS (cETLus)
CONTAINERIZED 2-PASS RO WITH PRETREATMENT
RIO PANEL

CLIENT: ELECTRIC HYDROGEN
BEAUMONT, TX

EVOQUA WATER TECHNOLOGIES
COLORADO SPRINGS CO USA
+1 719-570-9600

PROJ/PROD NUMBER	CODE	FILE/DRAWING NUMBER	SHEET	REV
2034/001845	EC-DOS03	V112057484-15	15 OF 20	2

STD: Electrical v4.3
BAR = 1" AT PLOT SCALE

NOTES: UNLESS OTHERWISE SPECIFIED

1. THIS PANEL TO BE MOUNTED INSIDE THE CONTAINER.
2. THIS ENCLOSURE IS TO BE NEMA 4.
3. MANUFACTURING TO LAYOUT BACKPANEL AS SHOWN.
4. ALL WIREWAYS TO BE 4" HIGH.
5. MANUFACTURING TO VERIFY ALL DIMENSIONS AND CUTOUT SIZES BEFORE CUTTING OR DRILLING PANEL.
6. DIN RAIL TO BE MOUNTED ON 1" STANDOFFS.
7. CONDUIT MATERIAL TO BE EMT.

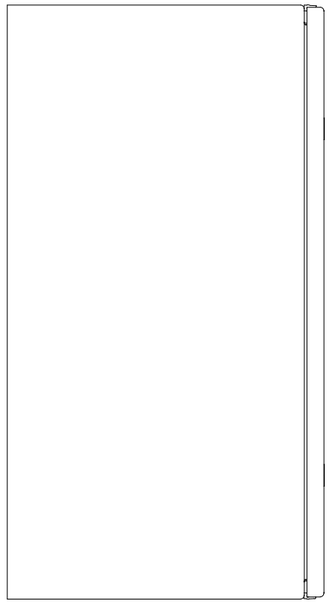

LEFT SIDE DETAIL

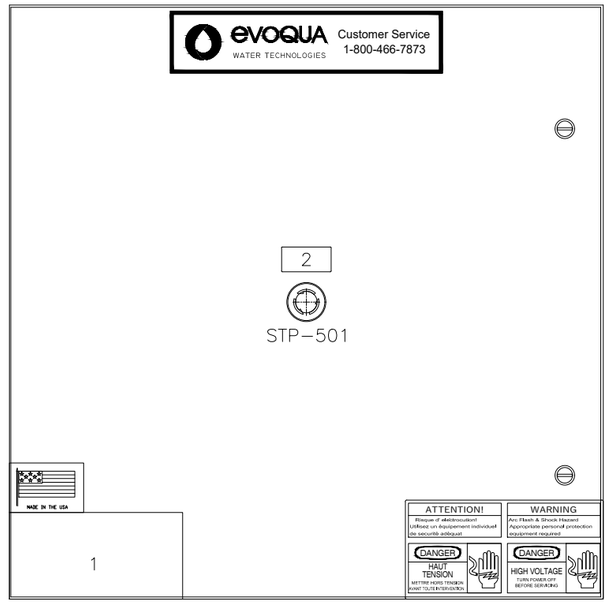

PANEL DETAIL

24" X 24" X 12"

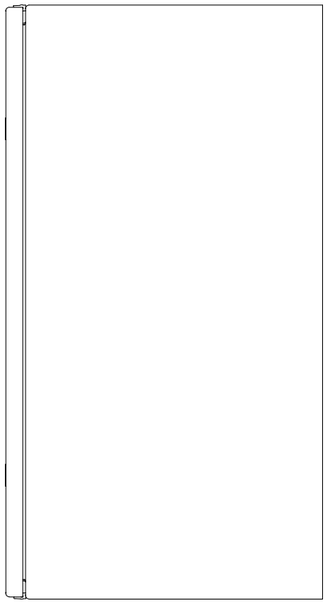

RIGHT SIDE DETAIL

REV	DESCRIPTION	DATE	DWN	CKD	APPD	ECN
2	REVISE SCHEMATIC NOTE #3	2024-05-14	C.HANER	K.KALUNG	K.KALUNG	ECM127665
1	ISSUED FOR CONSTRUCTION	2024-03-26	M.KALIRA	K.KISITU	K.KISITU	-
0	ISSUED FOR CONSTRUCTION	2023-12-28	M.KALIRA	S.THANGA	K.KISITU	N/A

COMPANY CONFIDENTIAL INFORMATION
THIS DOCUMENT AND ALL INFORMATION CONTAINED HEREIN, INCLUDING THE DESIGN CONCEPTS AND THOSE ARISING THEREFROM, ARE THE PROPERTY OF EVOQUA AND/OR ITS AFFILIATES AND ARE SUBMITTED IN CONFIDENCE. THEY MAY BE USED ONLY FOR THE EXPRESS PURPOSE FOR WHICH THEY ARE PROVIDED AND MUST NOT BE DISCLOSED, REPRODUCED, OR COPIED IN ANY FORM, INCLUDING IN ELECTRONIC FORMAT, LOANED OR USED IN ANY OTHER MANNER WITHOUT THE PRIOR WRITTEN CONSENT OF EVOQUA. ALL PATENT RIGHTS ARE RESERVED. THIS DOCUMENT AND DERIVATIVE WORKS THEREOF ARE PROTECTED UNDER APPLICABLE COPYRIGHT LAWS. UPON DEMAND OF EVOQUA, THIS DOCUMENT, ALONG WITH ALL COPIES AND EXTRACTS, AND ALL RELATED NOTES AND ANALYSES MUST BE RETURNED TO EVOQUA OR DESTROYED, AS INSTRUCTED BY EVOQUA. ACCEPTANCE OF THE DELIVERY OF THIS DOCUMENT CONSTITUTES AGREEMENT TO THESE TERMS.

DWN BY: M.KALIRA	DATE 2023-12-11
CKD BY: S.THANGA	DATE 2023-12-11
APPD BY: K.KISITU	DATE 2023-12-11
MGD BY: P.RYAN	SCALE NTS
PART NUMBER W3T602505	

TITLE: ELECTRICAL SCHEMATICS & ENCLOSURE DIAGRAMS (cETLus)
CONTAINERIZED 2-PASS RO WITH PRETREATMENT
RIO PANEL

CLIENT: ELECTRIC HYDROGEN
BEAUMONT, TX

EVOQUA WATER TECHNOLOGIES
COLORADO SPRINGS CO USA
+1 719-570-9600

PROJ/PROD NUMBER	CODE	FILE/DRAWING NUMBER	SHEET	REV
2034/001845	EC-DOS03	V112057484-16	16 OF 20	2

STD_Electrical_v4.3 BAR = 1" AT PLOT SCALE

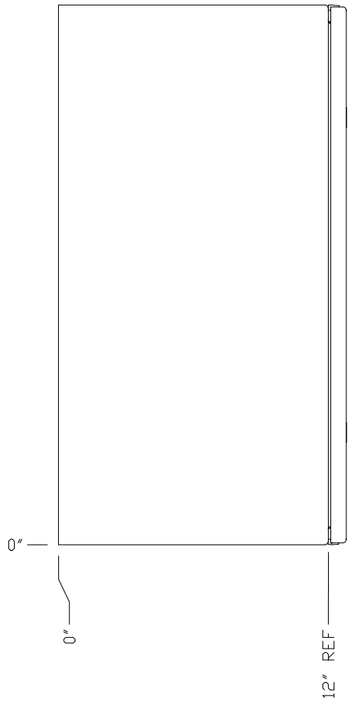

LEFT SIDE DETAILS

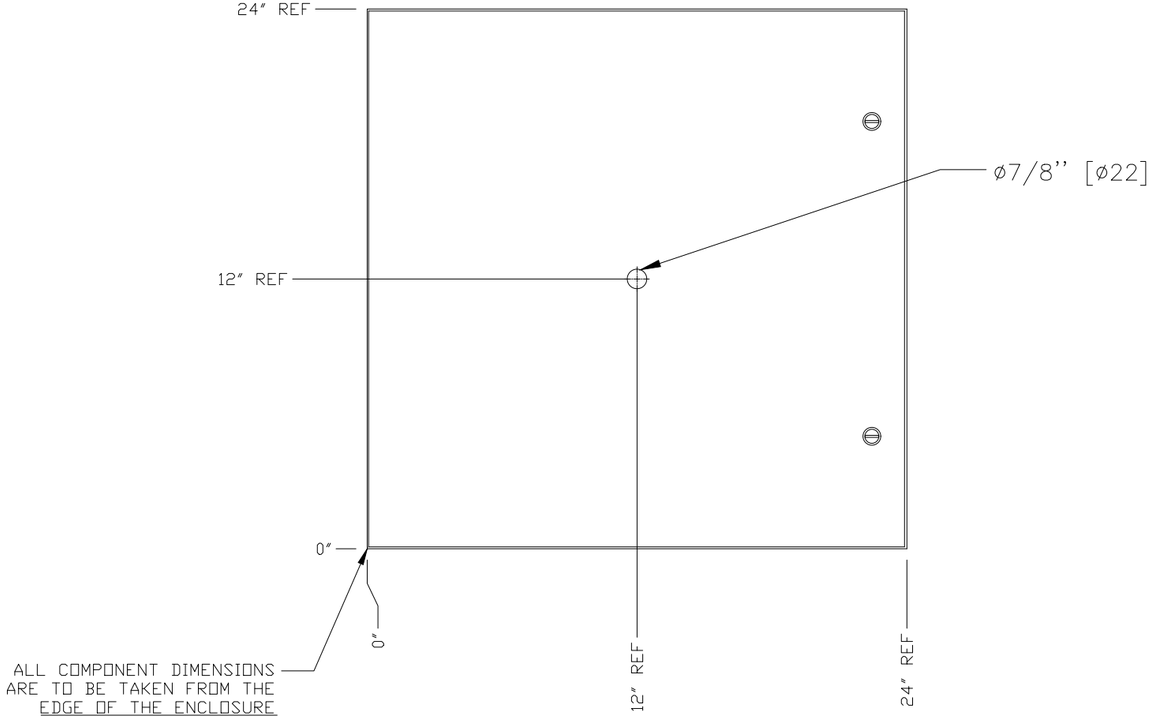

PANEL LAYOUT DETAILS

RIGHT SIDE DETAILS

REV	DESCRIPTION	DATE	DWN	CKD	APPD	ECN
2	REVISE SCHEMATIC NOTE #3	2024-05-14	C.HANER	K.KALUNG	K.KALUNG	ECM127665
1	ISSUED FOR CONSTRUCTION	2024-03-26	M.KALIRA	K.KISITU	K.KISITU	-
0	ISSUED FOR CONSTRUCTION	2023-12-28	M.KALIRA	S.THANGA	K.KISITU	N/A

COMPANY CONFIDENTIAL INFORMATION
THIS DOCUMENT AND ALL INFORMATION CONTAINED HEREIN, INCLUDING THE DESIGN CONCEPTS AND THOSE ARISING THEREFROM, ARE THE PROPERTY OF EVOQUA AND/OR ITS AFFILIATES AND ARE SUBMITTED IN CONFIDENCE. THEY MAY BE USED ONLY FOR THE EXPRESS PURPOSE FOR WHICH THEY ARE PROVIDED AND MUST NOT BE DISCLOSED, REPRODUCED, OR COPIED IN ANY FORM, INCLUDING IN ELECTRONIC FORMAT, LOANED OR USED IN ANY OTHER MANNER WITHOUT THE PRIOR WRITTEN PERMISSION OF EVOQUA. ALL PATENT RIGHTS ARE RESERVED. THIS DOCUMENT AND DERIVATIVE WORKS THEREOF ARE PROTECTED UNDER APPLICABLE COPYRIGHT LAWS. UPON DEMAND OF EVOQUA, THIS DOCUMENT, ALONG WITH ALL COPIES AND EXTRACTS, AND ALL RELATED NOTES AND ANALYSES MUST BE RETURNED TO EVOQUA OR DESTROYED, AS INSTRUCTED BY EVOQUA. ACCEPTANCE OF THE DELIVERY OF THIS DOCUMENT CONSTITUTES AGREEMENT TO THESE TERMS.

DWN BY: M.KALIRA	DATE 2023-12-11
CKD BY: S.THANGA	DATE 2023-12-11
APPD BY: K.KISITU	DATE 2023-12-11
MGD BY: P.RYAN	SCALE NTS
PART NUMBER W3T602505	

TITLE: ELECTRICAL SCHEMATICS & ENCLOSURE DIAGRAMS (cETLus)
CONTAINERIZED 2-PASS RO WITH PRETREATMENT
RIO PANEL

CLIENT: ELECTRIC HYDROGEN
BEAUMONT, TX

EVOQUA WATER TECHNOLOGIES
COLORADO SPRINGS CO USA
+1 719-570-9600

PROJ/PROD NUMBER	CODE	FILE/DRAWING NUMBER	SHEET	REV
2034/001845	EC-DOS03	V112057484-17	17 OF 20	2

STD_Electrical_v4.3
BAR = 1" AT PLOT SCALE

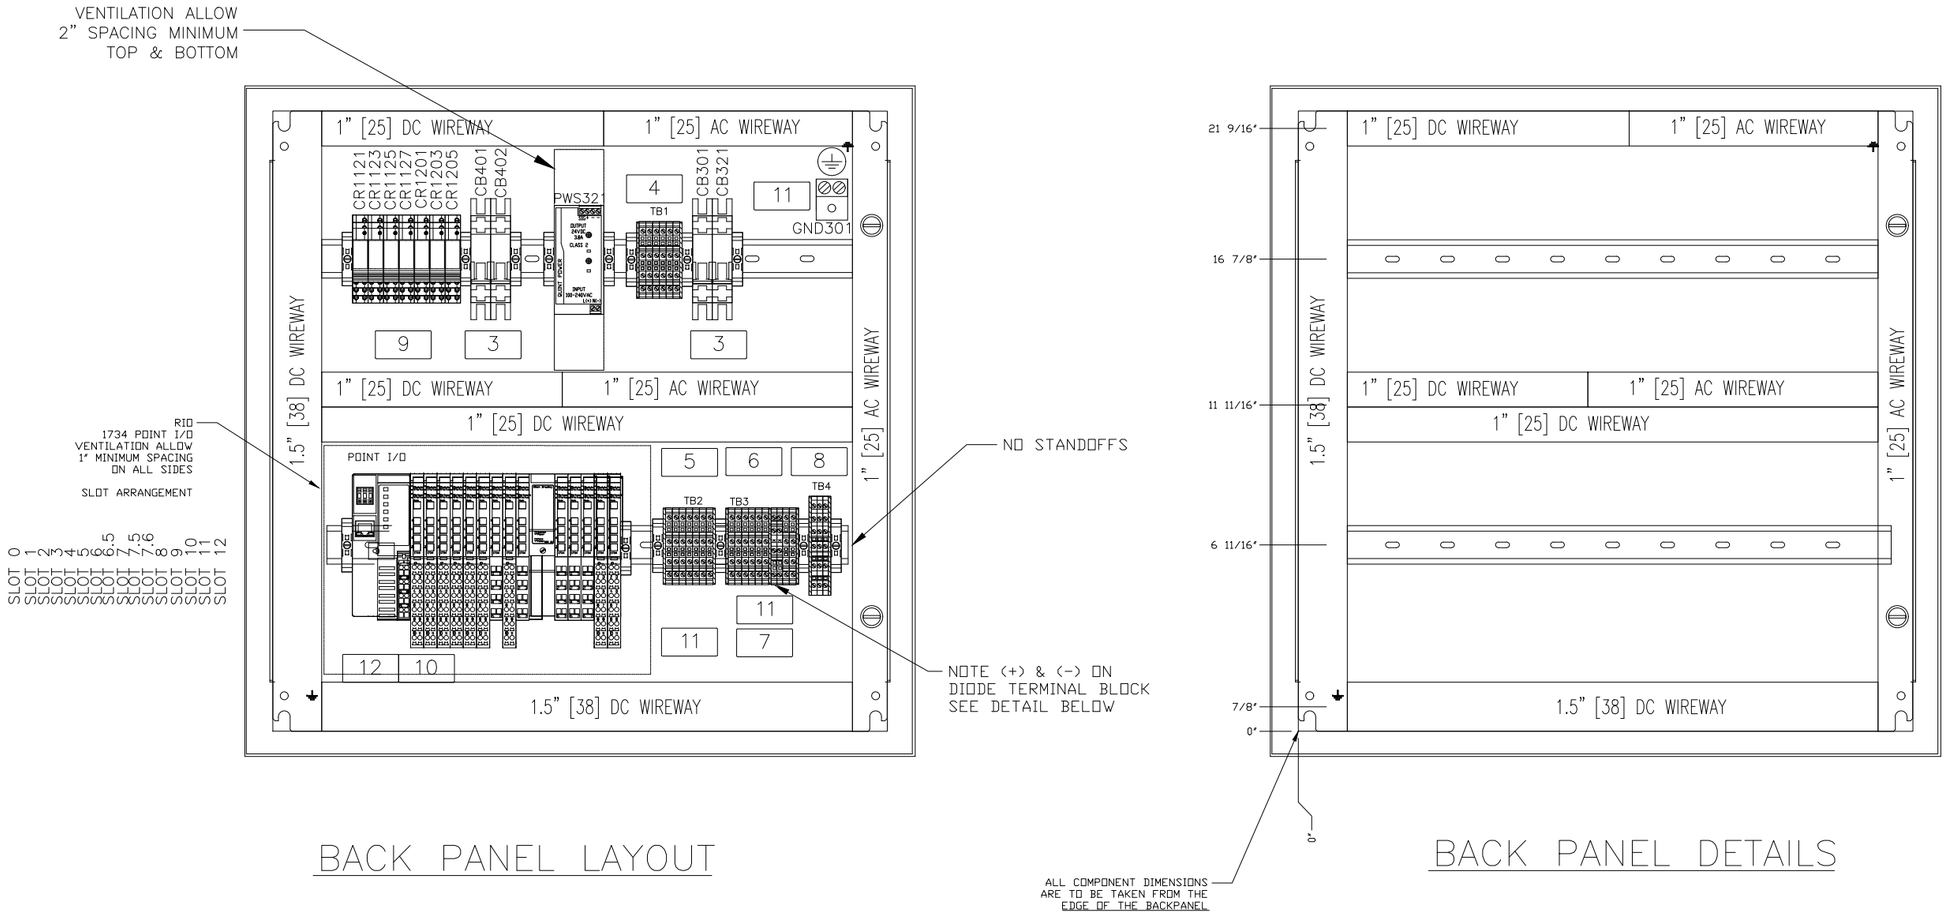

BACK PANEL LAYOUT

BACK PANEL DETAILS

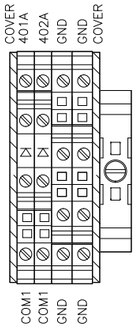

DIODE TERMINAL DETAIL

REV	DESCRIPTION	DATE	DWN	CKD	APPD	ECN
2	REVISE SCHEMATIC NOTE #3	2024-05-14	C.HANER	K.KALUNG	K.KALUNG	ECM127665
1	ISSUED FOR CONSTRUCTION	2024-03-26	M.KALIRA	K.KISITU	K.KISITU	-
0	ISSUED FOR CONSTRUCTION	2023-12-28	M.KALIRA	S.THANGA	K.KISITU	N/A

COMPANY CONFIDENTIAL INFORMATION
THIS DOCUMENT AND ALL INFORMATION CONTAINED HEREIN, INCLUDING THE DESIGN CONCEPTS AND THOSE ARISING THEREFROM, ARE THE PROPERTY OF EVOQUA AND/OR ITS AFFILIATES AND ARE SUBMITTED IN CONFIDENCE. THEY MAY BE USED ONLY FOR THE EXPRESS PURPOSE FOR WHICH THEY ARE PROVIDED AND MUST NOT BE DISCLOSED, REPRODUCED, OR COPIED IN ANY FORM, INCLUDING IN ELECTRONIC FORMAT, LOANED OR USED IN ANY OTHER MANNER WITHOUT THE EXPRESS WRITTEN CONSENT OF EVOQUA. ALL PATENT RIGHTS ARE RESERVED. THIS DOCUMENT AND DERIVATIVE WORKS THEREOF ARE PROTECTED UNDER APPLICABLE COPYRIGHT LAWS. UPON DEMAND OF EVOQUA, THIS DOCUMENT, ALONG WITH ALL COPIES AND EXTRACTS, AND ALL RELATED NOTES AND ANALYSES MUST BE RETURNED TO EVOQUA OR DESTROYED, AT EVOQUA'S OPTION. ACCEPTANCE OF THE DELIVERY OF THIS DOCUMENT CONSTITUTES AGREEMENT TO THESE TERMS.

DWN BY: M.KALIRA	DATE 2023-12-11
CKD BY: S.THANGA	DATE 2023-12-11
APPD BY: K.KISITU	DATE 2023-12-11
MGD BY: P.RYAN	SCALE NTS
PART NUMBER W3T602505	

TITLE: ELECTRICAL SCHEMATICS & ENCLOSURE DIAGRAMS (cETLus)
CONTAINERIZED 2-PASS RO WITH PRETREATMENT
RIO PANEL

CLIENT: ELECTRIC HYDROGEN
BEAUMONT, TX

EVOQUA WATER TECHNOLOGIES
COLORADO SPRINGS CO USA
+1 719-570-9600

PROJ/PROD NUMBER	CODE	FILE/DRAWING NUMBER	SHEET	REV
2034/001845	EC-DOS03	V112057484-18	18 OF 20	2

STD: Electrical v4.3
BAR = 1" AT PLOT SCALE

	TB1 - AC	
	BOTTOM	TOP
1	N	L
	N	L
	GND	GND
	GND	GND
	SPARE	SPARE
6	SPARE	SPARE

	TB2 - DC	
	BOTTOM	TOP
1	COM	24+
	COM	24+
	COM	24+
	COM	24+
	COM	24+STP
	SPARE	24+STP
7	SPARE	SPARE

	TB3 - RELAY	
	BOTTOM	TOP
1	1402	1401
	1404	1403
	1406	1405
	1412	1411
	1430	1429
6	SPARE	SPARE

	TB3 - DIODE	
	BOTTOM	TOP
1	COM	401A
	COM	402A
	GND	GND
4	GND	GND

	TB4 - DC		
	BOTTOM	MIDDLE	TOP
1	SH/GND	SH/GND	SH/GND
	SPARE	SPARE	SH/GND
3	SPARE	SPARE	SPARE

REV	DESCRIPTION	DATE	DWN	CKD	APPD	ECN
2	REVISE SCHEMATIC NOTE #3	2024-05-14	C.HANER	K.KALUNG	K.KALUNG	ECM127665
1	ISSUED FOR CONSTRUCTION	2024-03-26	M.KALIRA	K.KISITU	K.KISITU	-
0	ISSUED FOR CONSTRUCTION	2023-12-28	M.KALIRA	S.THANGA	K.KISITU	N/A

COMPANY CONFIDENTIAL INFORMATION
THIS DOCUMENT AND ALL INFORMATION CONTAINED HEREIN, INCLUDING THE DESIGN CONCEPTS AND THOSE ARISING THEREFROM, ARE THE PROPERTY OF EVOQUA AND/OR ITS AFFILIATES AND ARE SUBMITTED IN CONFIDENCE. THEY MAY BE USED ONLY FOR THE EXPRESS PURPOSE FOR WHICH THEY ARE PROVIDED AND MUST NOT BE DISCLOSED, REPRODUCED, OR COPIED IN ANY FORM, INCLUDING IN ELECTRONIC FORMAT, LOANED OR USED IN ANY OTHER MANNER WITHOUT THE PRIOR WRITTEN PERMISSION OF EVOQUA. ALL PATENT RIGHTS ARE RESERVED. THIS DOCUMENT AND DERIVATIVE WORKS THEREOF ARE PROTECTED UNDER APPLICABLE COPYRIGHT LAWS. UPON DEMAND OF EVOQUA, THIS DOCUMENT, ALONG WITH ALL COPIES AND EXTRACTS, AND ALL RELATED NOTES AND ANALYSES MUST BE RETURNED TO EVOQUA OR DESTROYED, AS INSTRUCTED BY EVOQUA. ACCEPTANCE OF THE DELIVERY OF THIS DOCUMENT CONSTITUTES AGREEMENT TO THESE TERMS.

DWN BY: M.KALIRA	DATE 2023-12-11
CKD BY: S.THANGA	DATE 2023-12-11
APPD BY: K.KISITU	DATE 2023-12-11
MGD BY: P.RYAN	SCALE NTS
PART NUMBER W3T602505	

TITLE: ELECTRICAL SCHEMATICS & ENCLOSURE DIAGRAMS (cETLus)
CONTAINERIZED 2-PASS RO WITH PRETREATMENT
RIO PANEL

CLIENT: ELECTRIC HYDROGEN
BEAUMONT, TX

EVOQUA WATER TECHNOLOGIES
COLORADO SPRINGS CO USA
+1 719-570-9600

PROJ/PROD NUMBER	CODE	FILE/DRAWING NUMBER	SHEET	REV
2034/001845	EC-DOS03	V112057484-19	19 OF 20	2

STD: Electrical v4.3 | BAR = 1" AT PLOT SCALE

NAMEPLATE LEGEND

NAMEPLATES TO BE 3/4" X 2" WHITE LAMACOID WITH 1/8" BLACK LETTERING. * DENOTES NAMEPLATE TO BE MOUNTED INSIDE ENCLOSURE.

RED W/WHITE LETTERING

X2

NO.	NAMEPLATE TEXT	REF
1	PANEL NAMEPLATE	SEE DETAIL THIS SHT
2	SYSTEM STOP	STP501
*3	CIRCUIT BREAKERS TORQUE TERMINALS TO 31 LB-IN.	CB301-CB402
*4	TB1 TORQUE TERMINALS TO 6.0 LB-IN.	TB1
*5	TB2 TORQUE TERMINALS TO 6.0 LB-IN.	TB2
*6	TB3 TORQUE TERMINALS TO 4.4 LB-IN.	TB3
*7	TB3 - DIODE TORQUE TERMINALS TO 5.3 LB-IN.	TB3
*8	TB4 TORQUE TERMINALS TO 6.0 LB-IN.	TB4
*9	CONTROL RELAYS TORQUE TERMINALS TO 9.0 LB-IN.	CR1121-CR1205
*10	CLASS 2 CONTROL CIRCUIT	-
*11	GROUND LUG TORQUE TERMINAL TO 35 LB-IN.	GND301
*12	POINT I/O TORQUE TERMINALS TO 5.0 LB-IN.	-

CONTAINERIZED 2-PASS RO WITH PRETREATMENT
RIO PANEL
FOR
ELECTRIC HYDROGEN
BEAUMONT, TX

EVOQUA WATER TECHNOLOGIES

Colorado Springs, CO
Industrial Control Panel (NEMA 4/UL Type-1 Enclosure)

ELEC DWG-V112057484 MECH DWG-V113616762

SOURCE	VOLTS	PHASE	Hz	FLA	HP	SCCR
1	120VAC	1Ø	60	0.83	-	14 kA RMS SYM

PANEL NAMEPLATE

SIZE LETTERING AS REQUIRED
WHITE LAMICOID WITH BLACK LETTERING
NAMEPLATE SIZE 3" X 7"

REV	DESCRIPTION	DATE	DWN	CKD	APPD	ECN
2	REVISE SCHEMATIC NOTE #3	2024-05-14	C.HANER	K.KALUNG	K.KALUNG	ECM127665
1	ISSUED FOR CONSTRUCTION	2024-03-26	M.KALIRA	K.KISITU	K.KISITU	-
0	ISSUED FOR CONSTRUCTION	2023-12-28	M.KALIRA	S.THANGA	K.KISITU	N/A

COMPANY CONFIDENTIAL INFORMATION
THIS DOCUMENT AND ALL INFORMATION CONTAINED HEREIN, INCLUDING THE DESIGN CONCEPTS AND THOSE ARISING THEREFROM, ARE THE PROPERTY OF EVOQUA AND/OR ITS AFFILIATES AND ARE SUBMITTED IN CONFIDENCE. THEY MAY BE USED ONLY FOR THE EXPRESS PURPOSE FOR WHICH THEY ARE PROVIDED AND MUST NOT BE DISCLOSED, REPRODUCED, OR COPIED IN ANY FORM, INCLUDING IN ELECTRONIC FORMAT, LOANED OR USED IN ANY OTHER MANNER WITHOUT THE PRIOR WRITTEN PERMISSION OF EVOQUA. ALL PATENT RIGHTS ARE RESERVED. THIS DOCUMENT AND DERIVATIVE WORKS THEREOF ARE PROTECTED UNDER APPLICABLE COPYRIGHT LAWS. UPON DEMAND OF EVOQUA, THIS DOCUMENT, ALONG WITH ALL COPIES AND EXTRACTS, AND ALL RELATED NOTES AND ANALYSES MUST BE RETURNED TO EVOQUA OR DESTROYED, AS INSTRUCTED BY EVOQUA. ACCEPTANCE OF THE DELIVERY OF THIS DOCUMENT CONSTITUTES AGREEMENT TO THESE TERMS.

DWN BY: M.KALIRA	DATE 2023-12-11
CKD BY: S.THANGA	DATE 2023-12-11
APPD BY: K.KISITU	DATE 2023-12-11
MGD BY: P.RYAN	SCALE NTS
PART NUMBER W3T602505	

TITLE: ELECTRICAL SCHEMATICS & ENCLOSURE DIAGRAMS (cETLus)
CONTAINERIZED 2-PASS RO WITH PRETREATMENT
RIO PANEL

CLIENT: ELECTRIC HYDROGEN
BEAUMONT, TX

EVOQUA WATER TECHNOLOGIES
COLORADO SPRINGS CO USA
+1 719-570-9600

PROJ/PROD NUMBER	CODE	FILE/DRAWING NUMBER	SHEET	REV
2034/001845	EC-DOS03	V112057484-20	20 OF 20	2

STD: Electrical v4.3
BAR = 1" AT PLOT SCALE